


SIEMENS
SIEMENS ENGINEERING SERVICES LTD.
AS-BUILT
DATE: 91-04-08
REVIEWED BY: *[Signature]*

LEGEND

PERMIT TO PRACTICE
SIEMENS ENGINEERING SERVICES LTD.
Signature: *[Signature]*
Date: 91-04-08
PERMIT NUMBER: P 2998
The Association of Professional Engineers,
Geologists and Geophysicists of Alberta

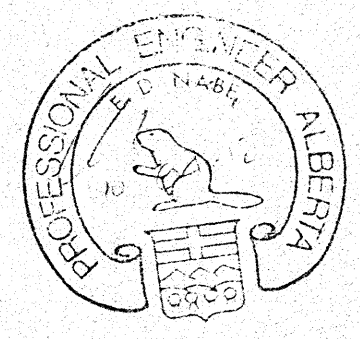

No.	DATE	DESCRIPTION	BY	APP.
1	11/90	AS BUILT	DF	PM
REVISIONS				

SCALE
300m 200 100 0 50 100m

DESIGNED BY
EDN

CHECKED BY
[Signature]

PROJECT No.
60-89-1

DRAWN BY
DFF

DATE
MAR., 1990

SIEMENS
SIEMENS ENGINEERING SERVICES LTD
CIVIL & MUNICIPAL ENGINEERS
DEVELOPMENT CONSULTANTS • PLANNERS

TRI-VILLAGE REGIONAL SEWAGE COMMISSION
SUMMER VILLAGES OF VAL QUENTIN,
ALBERTA BEACH AND SUNSET POINT
SEWAGE COLLECTION SYSTEM
LOCATION PLAN
EXISTING SEWAGE TREATMENT FACILITIES
SHEET 1 OF 1 DWG. No. 01