

LAC STE. ANNE

HUDSON'S BAY RESERVE
2.53

SUMMER VILLAGE OF ALBERTA BEACH
CORPORATE LIMITS

SCHOOL
I-M.C.R.

R.L. 16

R.L. 17

R.L. 18

SUMMER VILLAGE OF VAL QUENTIN
CORPORATE LIMITS

Contract 1

Contract 2

Contract 3

16
54-3-5

15
54-3-5

14
54-3-5

HWY. NO. 33


SANITARY
LAND FILL

SIEMENS
SIEMENS ENGINEERING SERVICES LTD.
AS-BUILT
DATE: 9/04/08
REVIEWED BY: [Signature]

2.10
PLAN AREA AND DRAWING NO.
90-05
TESTHOLE AND NUMBER

LEGEND

PERMIT TO PRACTICE
SIEMENS ENGINEERING SERVICES LTD.
Signature: [Signature]
Date: 90-04-12
PERMIT NUMBER: P 2998
The Association of Professional Engineers,
Geologists and Geophysicists of Alberta

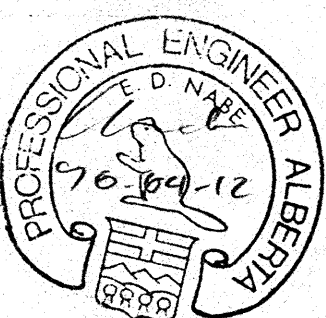

No.	DATE	DESCRIPTION	BY	APP
1	11/90	AS BUILT	DF	PM
REVISIONS				

SCALE
150m 100 50 25 0 50m

DESIGNED BY
EDN

CHECKED BY
[Signature]

PROJECT No.
60-89-1

DRAWN BY
DFF

DATE
MAR., 1990

SIEMENS
SIEMENS ENGINEERING SERVICES LTD.
CIVIL & MUNICIPAL ENGINEERS
DEVELOPMENT CONSULTANTS • PLANNERS

TRI-VILLAGE REGIONAL SEWAGE COMMISSION

SUMMER VILLAGES OF
VAL QUENTIN AND ALBERTA BEACH
SEWAGE COLLECTION SYSTEM

DRAWING INDEX PLAN
TEST HOLE LOCATIONS

SHEET OF DWG. No. 04