

- NOTES:
1. LOCATION OF EXISTING UTILITIES ARE APPROXIMATE ONLY (A.G.T., GAS, ETC.)
  2. UTILITIES MAY EXIST WHICH ARE NOT SHOWN ON THIS DRAWING.
  3. CONTRACTOR IS RESPONSIBLE FOR GETTING UTILITY COMPANIES TO MARK OUT ALL THEIR LINES (MANS AND SERVICES).
  4. CONTRACTOR IS RESPONSIBLE FOR ANY DAMAGE TO EXISTING UTILITIES WHETHER SHOWN ON THIS DRAWING OR NOT.

**SIEMENS**  
SIEMENS ENGINEERING SERVICES LTD.  
**AS-BUILT**  
DATE: 9-04-08  
REVIEWED BY: [Signature]


**LEGEND**

- GRAVITY SEWER, MANHOLE, INVERT, AND DIRECTION OF FLOW
- FORCE MAIN
- EXISTING GROUND PROFILE AT CONSTRUCTION SITE
- EXISTING PROPERTY LINE PROFILE, AT RIGHT
- EXISTING PROPERTY LINE PROFILE, AT LEFT
- EXISTING DITCH AT RIGHT OF ROAD
- EXISTING DITCH AT LEFT OF ROAD
- FOUND LEGAL MARKER
- POWER POLE W/ GUY
- GUY POLE, SERVICE OR LIGHT STANDARD POLE
- HAND PUMP

**TEST HOLE OR BOREHOLE**

- AGT PEDESTAL
- CSP CULVERT WIDIA
- CONC. CULVERT WIDIA
- FENCE (W/ WIRE, CLF-CHAIN LINK, BF-BOARD, RF-RAIL, GR-GUARDRAIL, SF-SNOW)
- GAS REGULATOR STATION
- CATCH BASIN
- POWER LINE
- GAS LINE
- TELEPHONE LINE

**PERMIT TO PRACTICE**  
SIEMENS ENGINEERING SERVICES LTD.  
Signature: [Signature]  
Date: 9-04-08  
PERMIT NUMBER: P 2998  
The Association of Professional Engineers, Geologists and Geophysicists of Alberta

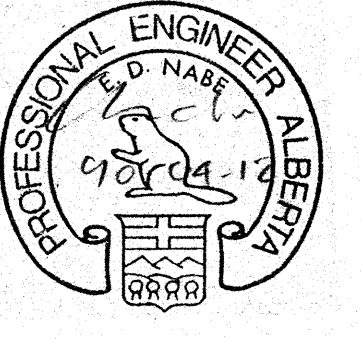

No.	DATE	DESCRIPTION	BY	APP
1	11/90	AS BUILT	DF	PM
REVISIONS				

SCALE  
HORIZ. 1:100  
VERT. 1:10

PROJECT No. 60-89-1

DESIGNED BY EDN  
DRAWN BY DFF/TG

CHECKED BY [Signature]  
DATE MAR., 1990

**SIEMENS**  
SIEMENS ENGINEERING SERVICES LTD.  
CIVIL & MUNICIPAL ENGINEERS  
DEVELOPMENT CONSULTANTS • PLANNERS

TRI-VILLAGE REGIONAL SEWAGE COMMISSION  
SUMMER VILLAGE OF VAL QUENTIN  
SEWAGE COLLECTION SYSTEM  
CRESTVIEW DRIVE

SHEET ..... OF ..... DWG. No. 1.13