


- NOTES:**
1. LOCATION OF EXISTING UTILITIES ARE APPROXIMATE ONLY (A.G.T., GAS, ETC.)
 2. UTILITIES MAY EXIST WHICH ARE NOT SHOWN ON THIS DRAWING.
 3. CONTRACTOR IS RESPONSIBLE FOR GETTING UTILITY COMPANIES TO MARK OUT ALL THEIR LINES (MAINS AND SERVICES).
 4. CONTRACTOR IS RESPONSIBLE FOR ANY DAMAGE TO EXISTING UTILITIES WHETHER SHOWN ON THIS DRAWING OR NOT.

SIEMENS
SIEMENS ENGINEERING SERVICES LTD.
AS-BUILT
DATE: 91-02-08
REVIEWED BY: [Signature]

LEGEND	
—○—	GRAVITY SEWER, MANHOLE, INVERT, AND DIRECTION OF FLOW
—	FORCEMAIN (100 DIA.)
---	EXISTING GROUND PROFILE AT CONSTRUCTION SITE
---	EXISTING PROPERTY LINE PROFILE, AT RIGHT
---	EXISTING PROPERTY LINE PROFILE, AT LEFT
---	EXISTING DITCH AT RIGHT OF ROAD
---	EXISTING DITCH AT LEFT OF ROAD
◆	FOUND LEGAL MARKER
○	POWER POLE W/ GLY
○	GLY POLE, SERVICE OR LIGHT STANDARD POLE
+	HAND PUMP
⊗	TEST HOLE OR BORE HOLE
□	AGT PEDESTAL
—	CSP CULVERT WIDIA.
—	CQC. CULVERT WIDIA.
—	FENCE (W/F-WIRE, CLF-CHAIN LINK, BF-BOARD, RF-RAIL, GR-GUARDRAIL, SF-SNOW)
△	GAS REGULATOR STATION
○	CATCH BASIN
—	POWER LINE
—	GAS LINE
—	TELEPHONE LINE
▼	SERVICE CONNECTION

PERMIT TO PRACTICE
SIEMENS ENGINEERING SERVICES LTD.
Signature: [Signature]
Date: 91-02-12
PERMIT NUMBER: P 2998
The Association of Professional Engineers,
Geologists and Geophysicists of Alberta

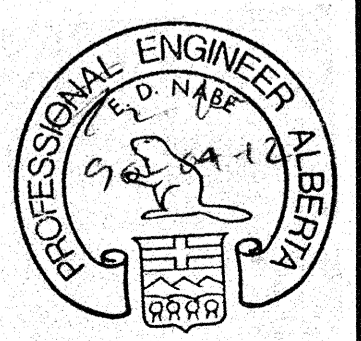

No.	DATE	DESCRIPTION	BY	APP
1	11/90	AS BUILT	DF	PM
REVISIONS				

SCALE
HORIZ. 10m 5 0 5
VERT. 1.0m 0.5 0 0.5

DESIGNED BY EDN

CHECKED BY [Signature]

PROJECT No. 60-89-1

DRAWN BY DFF/TG

DATE MAR., 1990

SIEMENS
SIEMENS ENGINEERING SERVICES LTD.
CIVIL & MUNICIPAL ENGINEERS
DEVELOPMENT CONSULTANTS • PLANNERS

TRI-VILLAGE REGIONAL SEWAGE COMMISSION
SUMMER VILLAGE OF VAL QUENTIN
SEWAGE COLLECTION SYSTEM
50th AVENUE
CRESTVIEW DR. E. to 63rd ST.
SHEET OF DWG. No. 1.6