


- NOTES:**
1. LOCATION OF EXISTING UTILITIES ARE APPROXIMATE ONLY (A.G.T., GAS, ETC.)
 2. UTILITIES MAY EXIST WHICH ARE NOT SHOWN ON THIS DRAWING.
 3. CONTRACTOR IS RESPONSIBLE FOR GETTING UTILITY COMPANIES TO MARK OUT ALL THEIR LINES (MAINS AND SERVICES).
 4. CONTRACTOR IS RESPONSIBLE FOR ANY DAMAGE TO EXISTING UTILITIES WHETHER SHOWN ON THIS DRAWING OR NOT.

SIEMENS
 SIEMENS ENGINEERING SERVICES LTD.
AS-BUILT
 DATE: 91-04-08
 REVIEWED BY: _____

GRAVITY SEWER, MANHOLE, INVERT, AND DIRECTION OF FLOW FORCEMAIN (100 DIA.) EXISTING GROUND PROFILE AT CONSTRUCTION SITE EXISTING PROPERTY LINE PROFILE, AT RIGHT EXISTING PROPERTY LINE PROFILE, AT LEFT EXISTING DITCH AT RIGHT OF ROAD EXISTING DITCH AT LEFT OF ROAD FOUND LEGAL MARKER POWER POLE W/ GUY GUY POLE, SERVICE OR LIGHT STANDARD POLE HAND PUMP	LEGEND TEST HOLE OR BORE HOLE AGT PEDESTAL CSP CULVERT WIDTH CONC. CULVERT WIDTH FENCE (W/WIRE, CLF-CHAIN LINK, BF-BOARD, RF-RAIL, GR-GUARDRAIL, SF-SNOW) GAS REGULATOR STATION CATCH BASIN POWER LINE GAS LINE TELEPHONE LINE SERVICE CONNECTION
---	---

PERMIT TO PRACTICE
 SIEMENS ENGINEERING SERVICES LTD.
 Signature: _____
 Date: 90-04-12
PERMIT NUMBER: P 2998
 The Association of Professional Engineers,
 Geologists and Geophysicists of Alberta

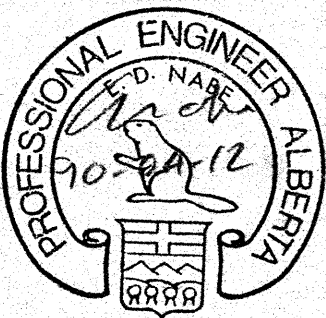

No.	DATE	DESCRIPTION	BY	APP
1	11/90	AS BUILT	DF	PM
REVISIONS				

SCALE HORIZ. 1:100 VERT. 1:10	PROJECT No. 60-89-1
DESIGNED BY EDN	DRAWN BY DFF / TG
CHECKED BY _____	DATE MAR., 1990

SIEMENS
 SIEMENS ENGINEERING SERVICES LTD.
 CIVIL & MUNICIPAL ENGINEERS
 DEVELOPMENT CONSULTANTS • PLANNERS

TRI-VILLAGE REGIONAL SEWAGE COMMISSION SUMMER VILLAGE OF VAL QUENTIN SEWAGE COLLECTION SYSTEM	
50th AVENUE 63rd ST. TO 60th ST.	
SHEET _____ OF _____	DWG. No. 1.7