

- NOTES**
1. LOCATION OF EXISTING UTILITIES ARE APPROXIMATE ONLY (A.G.T., GAS, ETC.)
 2. UTILITIES MAY EXIST WHICH ARE NOT SHOWN ON THIS DRAWING.
 3. CONTRACTOR IS RESPONSIBLE FOR GETTING UTILITY COMPANIES TO MARK OUT ALL THEIR LINES (MANS AND SERVICES).
 4. CONTRACTOR IS RESPONSIBLE FOR ANY DAMAGE TO EXISTING UTILITIES WHETHER SHOWN ON THIS DRAWING OR NOT.

SIEMENS
SIEMENS ENGINEERING SERVICES LTD.

AS-BUILT

DATE: 91-04-08
REVIEWED BY: *[Signature]*


LEGEND

○	GRAVITY SEWER, MANHOLE, INVERT, AND DIRECTION OF FLOW	○	TEST HOLE OR BORE HOLE
○	FORCE MAIN (150 DIA.)	□	AGT PEDESTAL
---	EXISTING GROUND PROFILE AT CONSTRUCTION SITE	---	CSP CULVERT WIDIA.
---	EXISTING PROPERTY LINE PROFILE, AT RIGHT	---	CONC. CULVERT WIDIA.
---	EXISTING PROPERTY LINE PROFILE, AT LEFT	---	FENCE (WF-WIRE, CLF-CHAIN LINK, BF-BOARD, RF-RAIL, GR-GUARDRAIL, SF-SNOW)
---	EXISTING DITCH AT RIGHT OF ROAD	△	GAS REGULATOR STATION
---	EXISTING DITCH AT LEFT OF ROAD	○	CATCH BASIN
◆	FOUND LEGAL MARKER	▽	SERVICE CONNECTION
○	POWER POLE W/ GLY	---	POWER LINE
○	GLY POLE, SERVICE OR LIGHT STANDARD POLE	---	GAS LINE
+	HAND PUMP	---	TELEPHONE LINE

PERMIT TO PRACTICE
SIEMENS ENGINEERING SERVICES LTD.

Signature: *[Signature]*
Date: 90-04-12

PERMIT NUMBER: P 2998
The Association of Professional Engineers,
Geologists and Geophysicists of Alberta

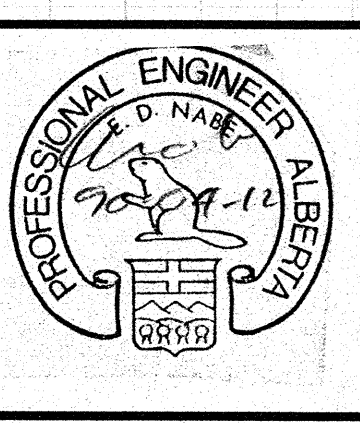

No.	DATE	DESCRIPTION	BY	APP
2	11/90	AS BUILT	DF	PM
1	1990 05 23	GRADE CHANGE	DF	EN

REVISIONS

SCALE
HORIZ. 10m 5 0 5
VERT. 1.0m 0.5 0 0.5

DESIGNED BY: *[Signature]*
CHECKED BY: *[Signature]*

PROJECT No. 60-89-1

DRAWN BY: DFF YJC

DATE: MAR., 1990

SIEMENS

SIEMENS ENGINEERING SERVICES LTD.
CIVIL & MUNICIPAL ENGINEERS
DEVELOPMENT CONSULTANTS • PLANNERS

TRI-VILLAGE REGIONAL SEWAGE COMMISSION

SUMMER VILLAGE OF ALBERTA BEACH SEWAGE COLLECTION SYSTEM

56th STREET/LANE/55th STREET
50th AVE. to 50th AVE.

SHEET OF DWG. No. 2.2