


LEGEND

○	TEST HOLE OR BORE HOLE
□	AGT PEDESTAL
—	CSP CULVERT WIDIA.
—	CONC. CULVERT WIDIA.
—	FENCE (WF-WIRE, CLF-CHAIN LINK, BF-BOARD, RF-RAIL, GR-GUARDRAIL, SF-SNOW)
△	GAS REGULATOR STATION
○	CATCH BASIN
—	POWER LINE
—	GAS LINE
—	TELEPHONE LINE
◆	SERVICE CONNECTION

PERMIT TO PRACTICE
SIEMENS ENGINEERING SERVICES LTD.
 Signature: *[Signature]*
 Date: 90-04-17
PERMIT NUMBER: P 2998
 The Association of Professional Engineers,
 Geologists and Geophysicists of Alberta

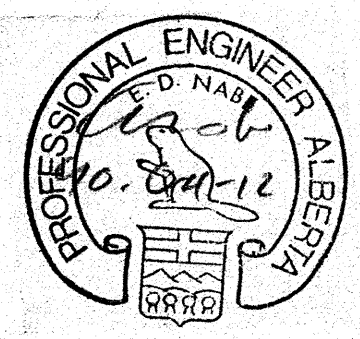

No.	DATE	DESCRIPTION	BY	APP
2	05/92	AS BUILT REVISED	DF	PM
1	11/90	AS BUILT	DF	PM

SCALE
 HORIZ. 1:1000
 VERT. 1:100

DESIGNED BY EDN

CHECKED BY *[Signature]*

PROJECT No. 60-89-1

DRAWN BY DFF YJC

DATE MAR., 1990

SIEMENS
 SIEMENS ENGINEERING SERVICES LTD.
 CIVIL & MUNICIPAL ENGINEERS
 DEVELOPMENT CONSULTANTS • PLANNERS

TRI-VILLAGE REGIONAL SEWAGE COMMISSION
 SUMMER VILLAGE OF ALBERTA BEACH
 SEWAGE COLLECTION SYSTEM

47th AVENUE
 52A ST. to 50A ST.

SHEET OF DWG. No. 2.22

SIEMENS
 SIEMENS ENGINEERING SERVICES LTD.
AS-BUILT
 DATE: 91-04-08
 REVIEWED BY: *[Signature]*

- NOTES:**
- LOCATION OF EXISTING UTILITIES ARE APPROXIMATE ONLY (A.G.T., GAS, ETC.)
 - UTILITIES MAY EXIST WHICH ARE NOT SHOWN ON THIS DRAWING.
 - CONTRACTOR IS RESPONSIBLE FOR GETTING UTILITY COMPANIES TO MARK OUT ALL THEIR LINES (MAINS AND SERVICES).
 - CONTRACTOR IS RESPONSIBLE FOR ANY DAMAGE TO EXISTING UTILITIES WHETHER SHOWN ON THIS DRAWING OR NOT.