


**SIEMENS**  
SIEMENS ENGINEERING SERVICES LTD.  
**AS-BUILT**  
DATE: 91.04.08  
REVIEWED BY: [Signature]

- NOTES:**
1. LOCATION OF EXISTING UTILITIES ARE APPROXIMATE ONLY (A.G.T., GAS, ETC.)
  2. UTILITIES MAY EXIST WHICH ARE NOT SHOWN ON THIS DRAWING.
  3. CONTRACTOR IS RESPONSIBLE FOR GETTING UTILITY COMPANIES TO MARK OUT ALL THEIR LINES (MANS AND SERVICES).
  4. CONTRACTOR IS RESPONSIBLE FOR ANY DAMAGE TO EXISTING UTILITIES WHETHER SHOWN ON THIS DRAWING OR NOT.

LEGEND	
○	GRAVITY SEWER, MANHOLE, INVERT, AND DIRECTION OF FLOW
○	FORCEMAIN
---	EXISTING GROUND PROFILE AT CONSTRUCTION SITE
---	EXISTING PROPERTY LINE PROFILE AT RIGHT
---	EXISTING PROPERTY LINE PROFILE AT LEFT
---	EXISTING DITCH AT RIGHT OF ROAD
---	EXISTING DITCH AT LEFT OF ROAD
◆	FOUND LEGAL MARKER
○	POWER POLE W/ GUY
○	GUY POLE, SERVICE OR LIGHT STANDARD POLE
⊕	HAND PUMP
○	TEST HOLE OR BORE HOLE
□	AGT PEDESTAL
---	CSP CULVERT WIDTH
---	CONC. CULVERT WIDTH
---	FENCE (WF-WIRE, CLF-CHAIN LINK, BF-BOARD, RF-RAIL, GR-GUARDRAIL, SF-SNOW)
○	GAS REGULATOR STATION
△	CATCH BASIN
---	POWER LINE
---	GAS LINE
---	TELEPHONE LINE
▼	SERVICE CONNECTION

**PERMIT TO PRACTICE**  
SIEMENS ENGINEERING SERVICES LTD.  
Signature: [Signature]  
Date: 90-04-12  
**PERMIT NUMBER: P 2998**  
The Association of Professional Engineers,  
Geologists and Geophysicists of Alberta

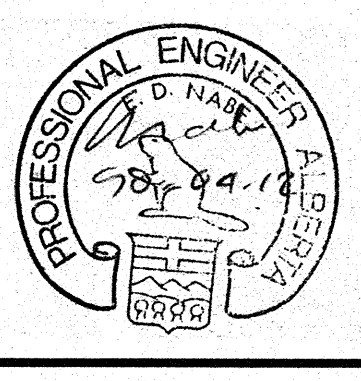

No.	DATE	DESCRIPTION	BY	APP
1	11/90	AS BUILT	DF	PM
<b>REVISIONS</b>				

SCALE HORIZ. 1:100 VERT. 1:10	PROJECT No. 60-89-1
DESIGNED BY EDN	DRAWN BY DFF YJC
CHECKED BY [Signature]	DATE MAR., 1990

**SIEMENS**  
SIEMENS ENGINEERING SERVICES LTD.  
CIVIL & MUNICIPAL ENGINEERS  
DEVELOPMENT CONSULTANTS • PLANNERS

**TRI-VILLAGE REGIONAL SEWAGE COMMISSION**  
**SUMMER VILLAGE OF ALBERTA BEACH SEWAGE COLLECTION SYSTEM**  
46th AVENUE  
SOUTHWEST OF 47th ST.  
SHEET OF DWG. No. 2.26