


**LEGEND**

<ul style="list-style-type: none"> <li>—○— GRAVITY SEWER, MANHOLE, INVERT, AND DIRECTION OF FLOW</li> <li>—○— FORCEMAIN (150 DIA.)</li> <li>—○— EXISTING GROUND PROFILE AT CONSTRUCTION SITE</li> <li>—○— EXISTING PROPERTY LINE PROFILE, AT RIGHT</li> <li>—○— EXISTING PROPERTY LINE PROFILE, AT LEFT</li> <li>—○— EXISTING DITCH AT LEFT OF ROAD</li> <li>—○— EXISTING DITCH AT RIGHT OF ROAD</li> <li>—○— FOUND LEGAL MARKER</li> <li>—○— POWER POLE W/ GUY</li> <li>—○— GUY POLE, SERVICE OR LIGHT STANDARD POLE</li> <li>—○— HAND PUMP</li> </ul>	<ul style="list-style-type: none"> <li>—○— TEST HOLE OR BORE HOLE</li> <li>—○— AGT PEDESTAL</li> <li>—○— CSP CULVERT WIDIA.</li> <li>—○— CONC. CULVERT WIDIA.</li> <li>—○— FENCE (W/F-WIRE, CLF-CHAIN LINK, BF-BOARD, RF-RAIL, GR-GUARDRAIL, SF-SNOW)</li> <li>—○— GAS REGULATOR STATION</li> <li>—○— CATCH BASIN</li> <li>—○— POWER LINE</li> <li>—○— GAS LINE</li> <li>—○— TELEPHONE LINE</li> <li>—○— SERVICE CONNECTION</li> </ul>
---	--

**PERMIT TO PRACTICE**  
**SIEMENS ENGINEERING SERVICES LTD.**  
 Signature: *[Signature]*  
 Date: 70-04-12  
**PERMIT NUMBER: P 2998**  
 The Association of Professional Engineers,  
 Geologists and Geophysicists of Alberta

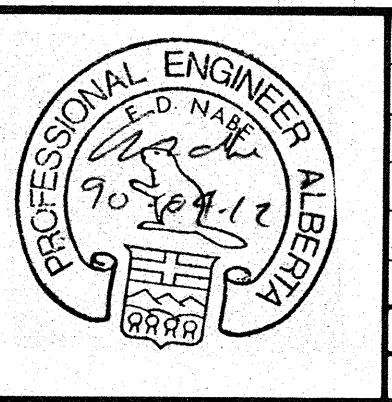

No.	DATE	DESCRIPTION	BY	APP
2	11/90	AS BUILT	DF	PM
1	1990 05 23	ADDITIONAL MANHOLE	DF	EN
REVISIONS				

DESIGNED BY EDN	DRAWN BY DFP YJC
CHECKED BY	DATE MAR., 1990

**SIEMENS**  
 SIEMENS ENGINEERING SERVICES LTD.  
 CIVIL & MUNICIPAL ENGINEERS  
 DEVELOPMENT CONSULTANTS • PLANNERS

**TRI-VILLAGE REGIONAL SEWAGE COMMISSION**  
**SUMMER VILLAGE OF ALBERTA BEACH**  
**SEWAGE COLLECTION SYSTEM**  
 58th STREET  
 51st AVE(LANE) to 49th AVE  
 SHEET \_\_\_\_\_ OF \_\_\_\_\_ DWG. No. 2.34

**SIEMENS**  
 SIEMENS ENGINEERING SERVICES LTD.  
**AS-BUILT**  
 DATE: 91-04-08  
 REVIEWED BY: *[Signature]*

- NOTES:**
- LOCATION OF EXISTING UTILITIES ARE APPROXIMATE ONLY (A.G.T., GAS, ETC.)
  - UTILITIES MAY EXIST WHICH ARE NOT SHOWN ON THIS DRAWING.
  - CONTRACTOR IS RESPONSIBLE FOR GETTING UTILITY COMPANIES TO MARK OUT ALL THEIR LINES (MAINS AND SERVICES).
  - CONTRACTOR IS RESPONSIBLE FOR ANY DAMAGE TO EXISTING UTILITIES WHETHER SHOWN ON THIS DRAWING OR NOT.

PROJECT No. 60-89-1