


SIEMENS
 SIEMENS ENGINEERING SERVICES LTD.
AS-BUILT
 DATE: 9/04/08
 REVIEWED BY: [Signature]

- NOTES:**
1. LOCATION OF EXISTING UTILITIES ARE APPROXIMATE ONLY (A.G.T., GAS, ETC.)
 2. UTILITIES MAY EXIST WHICH ARE NOT SHOWN ON THIS DRAWING.
 3. CONTRACTOR IS RESPONSIBLE FOR GETTING UTILITY COMPANIES TO MARK OUT ALL THEIR LINES (MAINS AND SERVICES).
 4. CONTRACTOR IS RESPONSIBLE FOR ANY DAMAGE TO EXISTING UTILITIES WHETHER SHOWN ON THIS DRAWING OR NOT.

SYMBOL	DESCRIPTION
○	GRAVITY SEWER, MANHOLE, INVERT, AND DIRECTION OF FLOW
○	FORCE MAIN (150 DIA.)
—	EXISTING GROUND PROFILE AT CONSTRUCTION SITE
—	EXISTING PROPERTY LINE PROFILE, AT RIGHT
—	EXISTING PROPERTY LINE PROFILE, AT LEFT
—	EXISTING DITCH AT RIGHT OF ROAD
—	EXISTING DITCH AT LEFT OF ROAD
+	FOUND LEGAL MARKER
—	POWER POLE W/ GUY
○	GUY POLE, SERVICE OR LIGHT STANDARD POLE
+	HAND PUMP
⊗	TEST HOLE OR BORE HOLE
□	AGT PEDESTAL
—	CSP CULVERT W/DIA.
—	CONC. CULVERT W/DIA.
—	FENCE (WF-WIRE, CLF-CHAIN LINK, BF-BOARD, RF-RAIL, GR-GUARDRAIL, SF-SNOW)
△	GAS REGULATOR STATION
○	CATCH BASIN
—	POWER LINE
—	GAS LINE
—	TELEPHONE LINE
▼	SERVICE CONNECTION

PERMIT TO PRACTICE
 SIEMENS ENGINEERING SERVICES LTD.
 Signature: [Signature]
 Date: 9/04/08
PERMIT NUMBER: P 2998
 The Association of Professional Engineers,
 Geologists and Geophysicists of Alberta

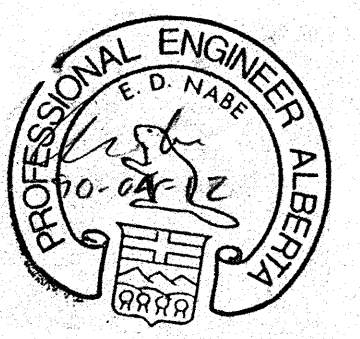

No.	DATE	DESCRIPTION	BY	APP
1	11/90	AS BUILT	DF	PM

SCALE HORIZ. VERT.	PROJECT No. 60-89-1
DESIGNED BY EDN	DRAWN BY DFF YJC
CHECKED BY [Signature]	DATE MAR., 1990

SIEMENS
 SIEMENS ENGINEERING SERVICES LTD.
 CIVIL & MUNICIPAL ENGINEERS
 DEVELOPMENT CONSULTANTS • PLANNERS

TRI-VILLAGE REGIONAL SEWAGE COMMISSION	
SUMMER VILLAGE OF ALBERTA BEACH SEWAGE COLLECTION SYSTEM	
57th STREET	
SHEET OF	DWG. No. 2.35