


SIEMENS
SIEMENS ENGINEERING SERVICES LTD.
AS-BUILT
DATE: 7-04-08
REVIEWED BY: [Signature]

- NOTES:**
1. LOCATION OF EXISTING UTILITIES ARE APPROXIMATE ONLY (A.G.T., GAS, ETC.)
 2. UTILITIES MAY EXIST WHICH ARE NOT SHOWN ON THIS DRAWING.
 3. CONTRACTOR IS RESPONSIBLE FOR GETTING UTILITY COMPANIES TO MARK OUT ALL THEIR LINES (MAINS AND SERVICES).
 4. CONTRACTOR IS RESPONSIBLE FOR ANY DAMAGE TO EXISTING UTILITIES WHETHER SHOWN ON THIS DRAWING OR NOT.

LEGEND

<ul style="list-style-type: none"> 724.843 MH GRAVITY SEWER, MANHOLE, INVERT, AND DIRECTION OF FLOW FORCE MAIN EXISTING GROUND PROFILE AT CONSTRUCTION SITE EXISTING PROPERTY LINE PROFILE, AT RIGHT EXISTING PROPERTY LINE PROFILE, AT LEFT EXISTING DITCH AT RIGHT OF ROAD EXISTING DITCH AT LEFT OF ROAD FOUND LEGAL MARKER POWER POLE W/ GUY GUY POLE, SERVICE OR LIGHT STANDARD POLE HAND PUMP 	<ul style="list-style-type: none"> TEST HOLE OR BORE-HOLE AGT PEDESTAL CSP CULVERT W/DIA. CONC. CULVERT W/DIA. FENCE (W/F WIRE, CULV-CHAIN LINK, BF-BOARD, RF-RAIL, CP-GUARDRAIL, SF-SNOW) GAS REGULATOR STATION CATCH BASIN POWER LINE GAS LINE TELEPHONE LINE SERVICE CONNECTION
---	---

PERMIT TO PRACTICE
SIEMENS ENGINEERING SERVICES LTD.
Signature: [Signature]
Date: 20-04-12
PERMIT NUMBER: P 2998
The Association of Professional Engineers,
Geologists and Geophysicists of Alberta

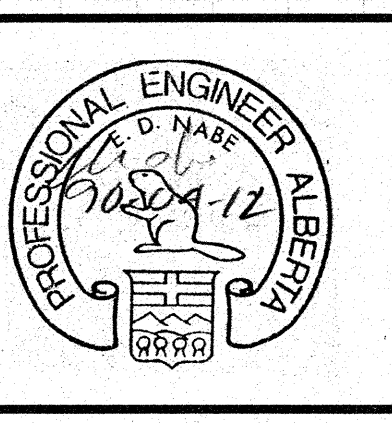

No.	DATE	DESCRIPTION	BY	APP
1	11/90	AS BUILT	DF	PM
REVISIONS				

SCALE HORIZ. 1:500 VERT. 1:100	PROJECT No. 60-89-1
DESIGNED BY EDN	DRAWN BY DFF YJC
CHECKED BY [Signature]	DATE MAR., 1990

SIEMENS
SIEMENS ENGINEERING SERVICES LTD.
CIVIL & MUNICIPAL ENGINEERS
DEVELOPMENT CONSULTANTS • PLANNERS

TRI-VILLAGE REGIONAL SEWAGE COMMISSION
SUMMER VILLAGE OF ALBERTA BEACH
SEWAGE COLLECTION SYSTEM
51A STREET
49th AVE. to 47th AVE.
SHEET OF DWG. No. 2.40