


LEGEND	
—○—	GRAVITY SEWER, MANHOLE, INVERT, AND DIRECTION OF FLOW
—	FORCEMAIN
---	EXISTING GROUND PROFILE AT CONSTRUCTION SITE
---	EXISTING PROPERTY LINE PROFILE, AT RIGHT
---	EXISTING PROPERTY LINE PROFILE, AT LEFT
---	EXISTING DITCH AT RIGHT OF ROAD
---	EXISTING DITCH AT LEFT OF ROAD
◆	FOUND LEGAL MARKER
—○—	POWER POLE W/ GUY
—○—	GUY POLE, SERVICE OR LIGHT STANDARD POLE
—	HAND PUMP
⊙	TEST HOLE OR BORE HOLE
⊠	AGT PEDESTAL
—	CSP CULVERT W/DIA.
—	CONC. CULVERT W/DIA.
—	FENCE (WF-WIRE, CLF-CHAIN LINK, BF-BOARD, RF-RAIL, GR-GUARADRAIL, SF-SNOW)
⊙	GAS REGULATOR STATION
⊙	CATCH BASIN
—	POWER LINE
—	GAS LINE
—	TELEPHONE LINE
—	SERVICE CONNECTION

**PERMIT TO PRACTICE**  
**SIEMENS ENGINEERING SERVICES LTD.**  
 Signature: *[Signature]*  
 Date: 90-04-12  
**PERMIT NUMBER: P 2998**  
 The Association of Professional Engineers,  
 Geologists and Geophysicists of Alberta

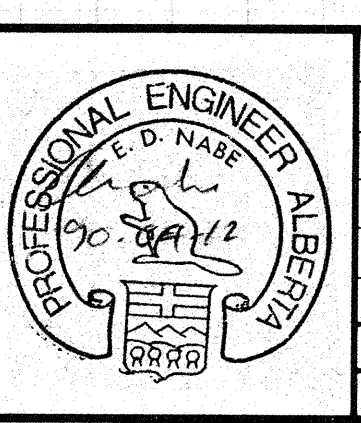

No.	DATE	DESCRIPTION	BY	APP
1	11/90	AS BUILT	DF	PM
REVISIONS				

SCALE  
 HORIZ. 1:1000  
 VERT. 1:100

DESIGNED BY EDN  
 CHECKED BY *[Signature]*

PROJECT No. 60-89-1  
 DRAWN BY DFF YJC  
 DATE MAR., 1990

**SIEMENS**  
 SIEMENS ENGINEERING SERVICES LTD.  
**AS-BUILT**  
 DATE: 91-04-08  
 REVIEWED BY: *[Signature]*

- NOTES:**
1. LOCATION OF EXISTING UTILITIES ARE APPROXIMATE ONLY (A.G.T., GAS, ETC.)
  2. UTILITIES MAY EXIST WHICH ARE NOT SHOWN ON THIS DRAWING.
  3. CONTRACTOR IS RESPONSIBLE FOR GETTING UTILITY COMPANIES TO MARK OUT ALL THEIR LINES (MAINS AND SERVICES).
  4. CONTRACTOR IS RESPONSIBLE FOR ANY DAMAGE TO EXISTING UTILITIES WHETHER SHOWN ON THIS DRAWING OR NOT.

**SIEMENS**  
 SIEMENS ENGINEERING SERVICES LTD.  
 CIVIL & MUNICIPAL ENGINEERS  
 DEVELOPMENT CONSULTANTS • PLANNERS

**TRI-VILLAGE REGIONAL SEWAGE COMMISSION**  
**SUMMER VILLAGE OF ALBERTA BEACH**  
**SEWAGE COLLECTION SYSTEM**  
 51st STREET  
 49th AVE. to 47th AVE.  
 SHEET \_\_\_\_\_ OF \_\_\_\_\_ DWG. No. 2.41