


SIEMENS
SIEMENS ENGINEERING SERVICES LTD.
AS-BUILT
DATE: 9-02-08
REVIEWED BY: [Signature]

- NOTES:**
1. LOCATION OF EXISTING UTILITIES ARE APPROXIMATE ONLY (A.G.T., GAS, ETC.)
 2. UTILITIES MAY EXIST WHICH ARE NOT SHOWN ON THIS DRAWING.
 3. CONTRACTOR IS RESPONSIBLE FOR GETTING UTILITY COMPANIES TO MARK OUT ALL THEIR LINES (MAINS AND SERVICES).
 4. CONTRACTOR IS RESPONSIBLE FOR ANY DAMAGE TO EXISTING UTILITIES WHETHER SHOWN ON THIS DRAWING OR NOT.

LEGEND

| | | | |
|-----|---|-----|---|
| —○— | GRAVITY SEWER, MANHOLE, INVERT, AND DIRECTION OF FLOW | ⊗ | TEST HOLE OR BORE HOLE |
| —○— | FORCEMAN | □ | AGT PEDESTAL |
| —○— | EXISTING GROUND PROFILE AT CONSTRUCTION SITE | —○— | CSP CULVERT WIDIA. |
| —○— | EXISTING PROPERTY LINE PROFILE AT RIGHT | —○— | CONC. CULVERT WIDIA. |
| —○— | EXISTING PROPERTY LINE PROFILE AT LEFT | —○— | FENCE (W-F-WIRE, C-F-CHAIN LINK, B-F-BOARD, R-F-RAIL, GR-GUARDRAIL, S-F-SNOW) |
| —○— | EXISTING DITCH AT RIGHT OF ROAD | —○— | GAS REGULATOR STATION |
| —○— | EXISTING DITCH AT LEFT OF ROAD | △ | CATCH BASIN |
| —○— | FOUND LEGAL MARKER | —○— | POWER LINE |
| —○— | POWER POLE W/ GUY | —○— | GAS LINE |
| —○— | GUY POLE, SERVICE OR LIGHT STANDARD POLE | —○— | TELEPHONE LINE |
| —○— | HAND PUMP | —○— | SERVICE CONNECTION |

PERMIT TO PRACTICE
SIEMENS ENGINEERING SERVICES LTD.
Signature: [Signature]
Date: 9-04-12
PERMIT NUMBER: P 2998
The Association of Professional Engineers,
Geologists and Geophysicists of Alberta

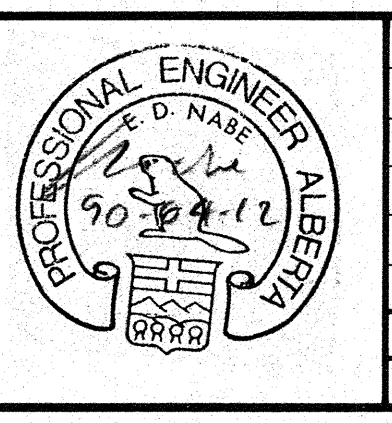

| No. | DATE | DESCRIPTION | BY | APP |
|-----------|-------|-------------|----|-----|
| 1 | 11/90 | AS BUILT | DF | PM |
| REVISIONS | | | | |

| | |
|-------------------------------------|---------------------|
| SCALE HORIZ. 1:100 VERT. 1:10 | PROJECT No. 60-89-1 |
| DESIGNED BY EDN | DRAWN BY DFF YJC |
| CHECKED BY [Signature] | DATE MAR., 1990 |

SIEMENS
SIEMENS ENGINEERING SERVICES LTD.
CIVIL & MUNICIPAL ENGINEERS
DEVELOPMENT CONSULTANTS • PLANNERS

TRI-VILLAGE REGIONAL SEWAGE COMMISSION
SUMMER VILLAGE OF ALBERTA BEACH SEWAGE COLLECTION SYSTEM
50A STREET
49th AVE. to 47th AVE.
SHEET OF DWG. No. 2.42