


**SIEMENS**  
SIEMENS ENGINEERING SERVICES LTD.  
**AS-BUILT**  
DATE: 91-04-08  
REVIEWED BY: [Signature]

- NOTES:
1. LOCATION OF EXISTING UTILITIES ARE APPROXIMATE ONLY (A.G.T., GAS, ETC.)
  2. UTILITIES MAY EXIST WHICH ARE NOT SHOWN ON THIS DRAWING.
  3. CONTRACTOR IS RESPONSIBLE FOR GETTING UTILITY COMPANIES TO MARK OUT ALL THEIR LINES (MANS AND SERVICES).
  4. CONTRACTOR IS RESPONSIBLE FOR ANY DAMAGE TO EXISTING UTILITIES WHETHER SHOWN ON THIS DRAWING OR NOT.

SYMBOL	DESCRIPTION
—	GRAVITY SEWER, MANHOLE, INVERT, AND DIRECTION OF FLOW
—	FORCEMAIN
—	EXISTING GROUND PROFILE AT CONSTRUCTION SITE
—	EXISTING PROPERTY LINE PROFILE, AT RIGHT
—	EXISTING PROPERTY LINE PROFILE, AT LEFT
—	EXISTING DITCH AT RIGHT OF ROAD
—	EXISTING DITCH AT LEFT OF ROAD
—	FOUND LEGAL MARKER
—	POWER POLE W/ GUY
—	GUY POLE, SERVICE OR LIGHT STANDARD POLE
—	HAND PUMP

PERMIT TO PRACTICE  
SIEMENS ENGINEERING SERVICES LTD.  
Signature: [Signature]  
Date: 91-04-12  
PERMIT NUMBER: P 2998  
The Association of Professional Engineers,  
Geologists and Geophysicists of Alberta

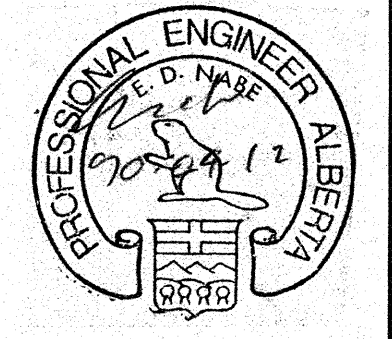

No.	DATE	DESCRIPTION	BY	APP
1	11/90	AS BUILT	DF	PM
REVISIONS				

SCALE HORIZ. VERT.	10m 5 0 5 1.0m 0.5 0 0.5
DESIGNED BY EDN	DRAWN BY DFP YJC
CHECKED BY	DATE MAR., 1990

PROJECT No.  
60-89-1

**SIEMENS**  
SIEMENS ENGINEERING SERVICES LTD.  
CIVIL & MUNICIPAL ENGINEERS  
DEVELOPMENT CONSULTANTS • PLANNERS

TRI-VILLAGE REGIONAL SEWAGE COMMISSION  
SUMMER VILLAGE OF ALBERTA BEACH  
SEWAGE COLLECTION SYSTEM  
47th STREET  
46th AVE. to 45th AVE.  
SHEET OF DWG. No. 2.45