


<ul style="list-style-type: none"> GRAVITY SEWER, MANHOLE, INVERT, AND DIRECTION OF FLOW FORCE MAIN (300 DIA.) EXISTING GROUND PROFILE AT CONSTRUCTION SITE EXISTING PROPERTY LINE PROFILE, AT RIGHT EXISTING PROPERTY LINE PROFILE, AT LEFT EXISTING DITCH AT RIGHT OF ROAD EXISTING DITCH AT LEFT OF ROAD FOUND LEGAL MARKER POWER POLE W/ GUY GUY POLE, SERVICE OR LIGHT STANDARD POLE HAND PUMP 	LEGEND <ul style="list-style-type: none"> TEST HOLE OR BORE HOLE AGT PEDESTAL CSP CULVERT W/DIA. CONC. CULVERT W/DIA. FENCE [W/ WIRE, CLF-CHAIN LINK, BF-BOARD, RF-RAIL, GR-GUARDRAIL, SF-SNOW] GAS REGULATOR STATION CATCH BASIN POWER LINE GAS LINE TELEPHONE LINE SERVICE CONNECTION
--------------------------------------------------------------------------------------------------------------------------------------------------------------------------------------------------------------------------------------------------------------------------------------------------------------------------------------------------------------------------------------------------------------------------------------------------------------------------------------------------------------	---------------------------------------------------------------------------------------------------------------------------------------------------------------------------------------------------------------------------------------------------------------------------------------------------------------------------------------------------------------------------------------------------------

PERMIT TO PRACTICE
SIEMENS ENGINEERING SERVICES LTD.
 Signature: *[Signature]*
 Date: 20-04-12
PERMIT NUMBER: P 2998
 The Association of Professional Engineers,
 Geologists and Geophysicists of Alberta

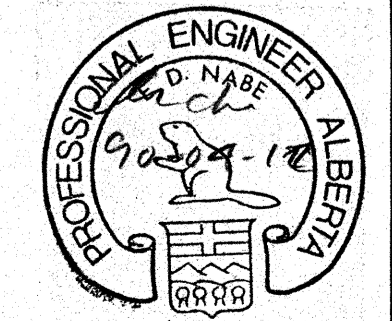

No.	DATE	DESCRIPTION	BY	APP
1	11/90	AS BUILT	DF	PM
REVISIONS				

SCALE
 HORIZ. 1:1000
 VERT. 1:100
 DESIGNED BY EDN
 CHECKED BY *[Signature]*

PROJECT No. 60-89-1
 DRAWN BY DFF YJC
 DATE MAR., 1990

SIEMENS
 SIEMENS ENGINEERING SERVICES LTD.
AS-BUILT
 DATE: 21-04-02
 REVIEWED BY: *[Signature]*

- NOTES:**
1. LOCATION OF EXISTING UTILITIES ARE APPROXIMATE ONLY (A.G.T., GAS, ETC.)
 2. UTILITIES MAY EXIST WHICH ARE NOT SHOWN ON THIS DRAWING.
 3. CONTRACTOR IS RESPONSIBLE FOR GETTING UTILITY COMPANIES TO MARK OUT ALL THEIR LINES (MAINS AND SERVICES).
 4. CONTRACTOR IS RESPONSIBLE FOR ANY DAMAGE TO EXISTING UTILITIES WHETHER SHOWN ON THIS DRAWING OR NOT.

SIEMENS
 SIEMENS ENGINEERING SERVICES LTD.
 CIVIL & MUNICIPAL ENGINEERS
 DEVELOPMENT CONSULTANTS • PLANNERS

TRI-VILLAGE REGIONAL SEWAGE COMMISSION
SUMMER VILLAGE OF ALBERTA BEACH
SEWAGE COLLECTION SYSTEM
 45th STREET
 50th AVE. TO 46th AVE.
 SHEET OF DWG. No. 2.49