


**SIEMENS**  
SIEMENS ENGINEERING SERVICES LTD.  
**AS-BUILT**  
DATE: 9/01/90  
REVIEWED BY: [Signature]

- NOTES:**
1. LOCATION OF EXISTING UTILITIES ARE APPROXIMATE ONLY (A.G.T., GAS, ETC.)
  2. UTILITIES MAY EXIST WHICH ARE NOT SHOWN ON THIS DRAWING.
  3. CONTRACTOR IS RESPONSIBLE FOR GETTING UTILITY COMPANIES TO MARK OUT ALL THEIR LINES (MAINS AND SERVICES).
  4. CONTRACTOR IS RESPONSIBLE FOR ANY DAMAGE TO EXISTING UTILITIES WHETHER SHOWN ON THIS DRAWING OR NOT.

**LEGEND**

<ul style="list-style-type: none"> <li>--- GRAVITY SEWER, MAN-HOLE, INVERT, AND DIRECTION OF FLOW</li> <li>--- FORCE MAIN (300 DIA.)</li> <li>--- EXISTING GROUND PROFILE AT CONSTRUCTION SITE</li> <li>--- EXISTING PROPERTY LINE PROFILE, AT RIGHT</li> <li>--- EXISTING PROPERTY LINE PROFILE, AT LEFT</li> <li>--- EXISTING DITCH AT RIGHT OF ROAD</li> <li>--- EXISTING DITCH AT LEFT OF ROAD</li> <li>◆ FOUND LEGAL MARKER</li> <li>○ POWER POLE W/GLY</li> <li>○ GLY POLE, SERVICE OR LIGHT STANDARD POLE</li> <li>⊕ HAND PUMP</li> </ul>	<ul style="list-style-type: none"> <li>⊙ TEST HOLE OR BORE HOLE</li> <li>□ AGT PEDESTAL</li> <li>--- CSP CULVERT W/DIA.</li> <li>--- CONC. CULVERT W/DIA.</li> <li>--- FENCE (WF-WIRE, CLF-CHAIN LINK, BF-BOARD, RF-RAIL, GR-GUARDRAIL, SF-SNOW)</li> <li>△ GAS REGULATOR STATION</li> <li>○ CATCH BASIN</li> <li>--- POWER LINE</li> <li>--- GAS LINE</li> <li>--- TELEPHONE LINE</li> <li>▼ SERVICE CONNECTION</li> </ul>
--	---

**PERMIT TO PRACTICE**  
SIEMENS ENGINEERING SERVICES LTD.  
Signature: [Signature]  
Date: 90-04-12  
**PERMIT NUMBER: P 2998**  
The Association of Professional Engineers, Geologists and Geophysicists of Alberta

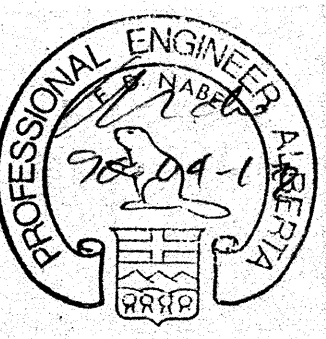

No.	DATE	DESCRIPTION	BY	APP
1	11/90	AS BUILT	DF	PM
REVISIONS				

SCALE  
HORIZ. 1:1000  
VERT. 1:100

DESIGNED BY: EDN  
CHECKED BY: [Signature]

PROJECT No. 60-89-1  
DRAWN BY: DFF YJC  
DATE: MAR., 1990

**SIEMENS**  
SIEMENS ENGINEERING SERVICES LTD.  
CIVIL & MUNICIPAL ENGINEERS  
DEVELOPMENT CONSULTANTS • PLANNERS

TRI-VILLAGE REGIONAL SEWAGE COMMISSION  
SUMMER VILLAGE OF ALBERTA BEACH  
SEWAGE COLLECTION SYSTEM  
43rd STREET  
50th AVE. to 47th AVE.  
SHEET OF DWG. No. 2.51