

NOTE:
 FORCEMAIN ELEVATIONS SHOWN AT HIGH POINTS (AIR RELEASE VALVE NO. 1 AND AIR RELEASE VALVE NO. 2) MUST BE SET AS SHOWN ON DRAWINGS. INVERTS AT OTHER LOCATIONS MAY BE ADJUSTED IN FIELD TO SUIT EXISTING GROUND ELEVATIONS PROVIDING NO ADDITIONAL HIGH POINTS ARE CREATED.

EXISTING SEWAGE LAGOON
 12 MONTH CELL




S.W. 1/4 SEC. 25-54-3-5

N.W. 1/4 SEC. 24-54-3-5

REFER TO
 DWG. 2.55

HUDSON'S BAY RESERVE

GOVERNMENT ROAD ALLOWANCE

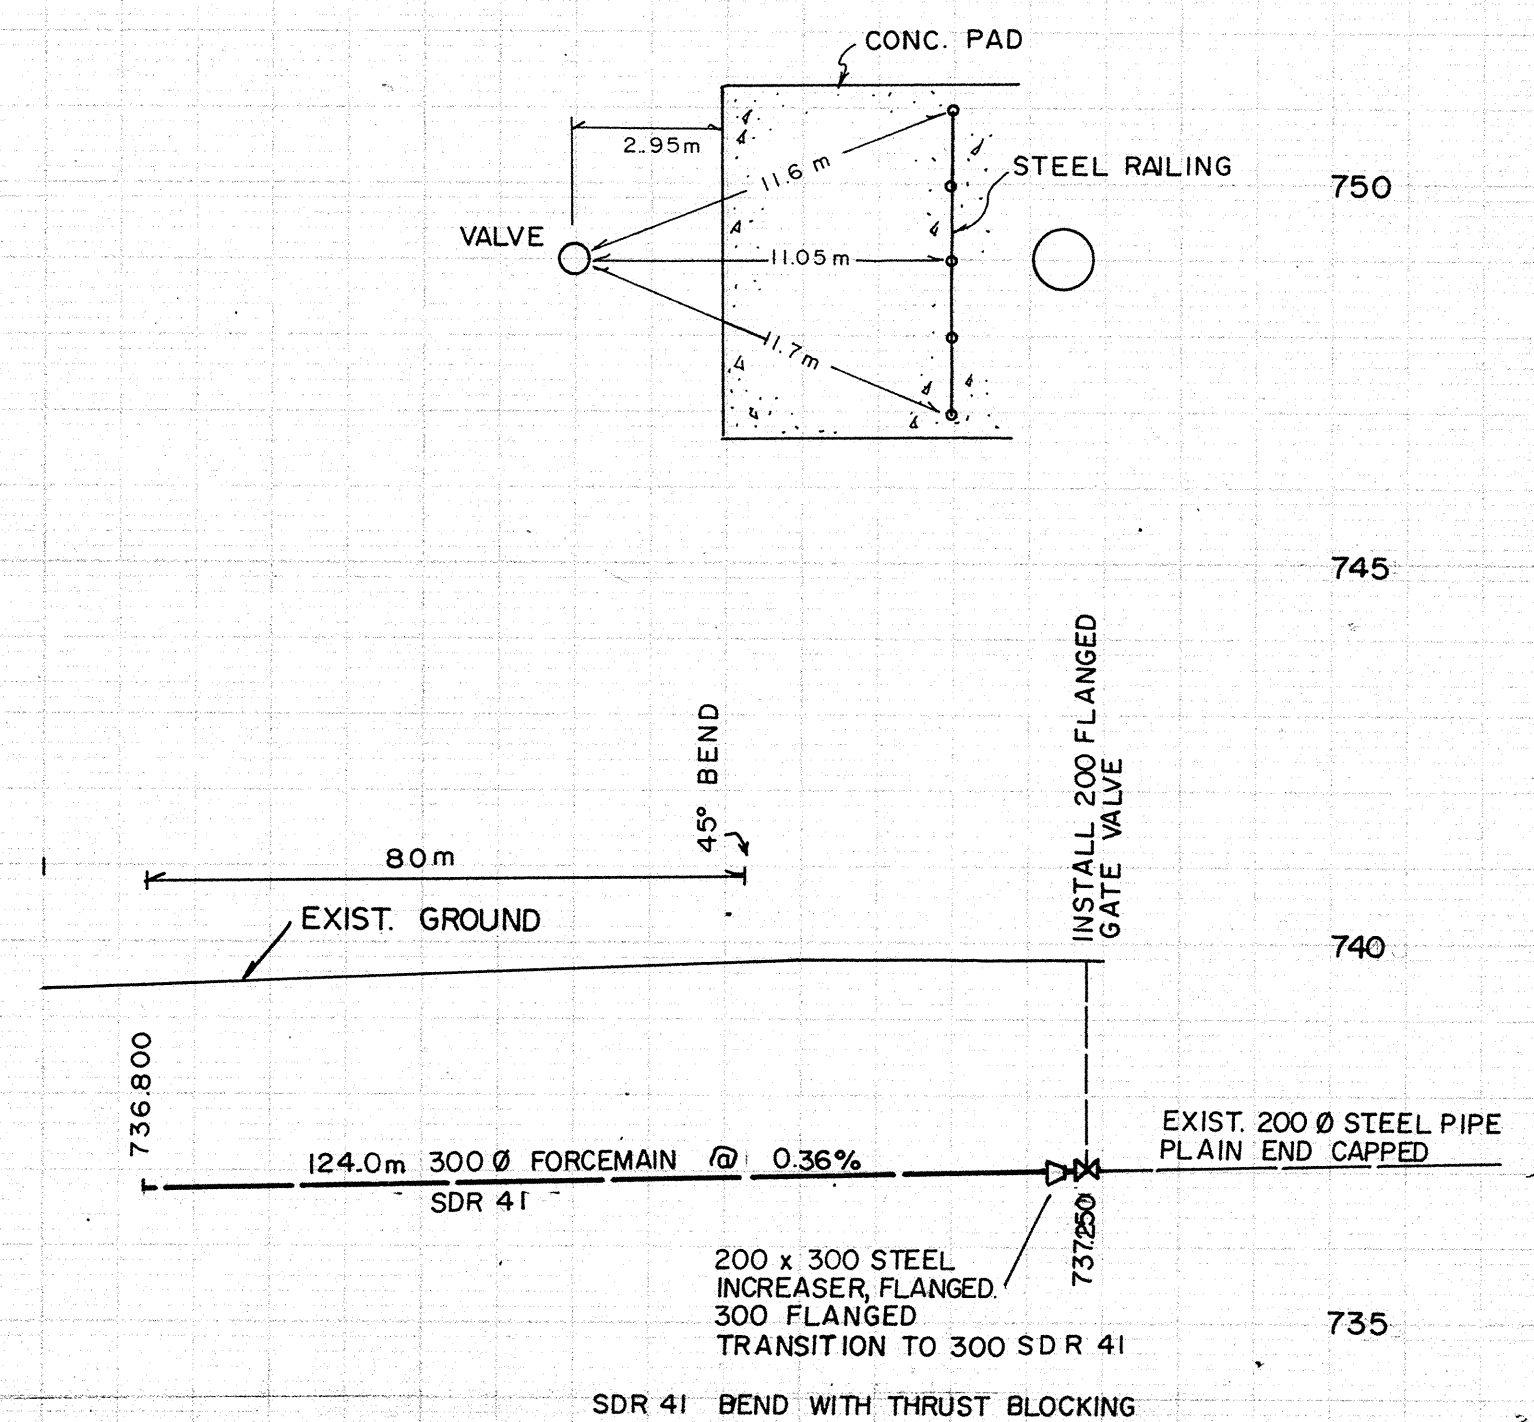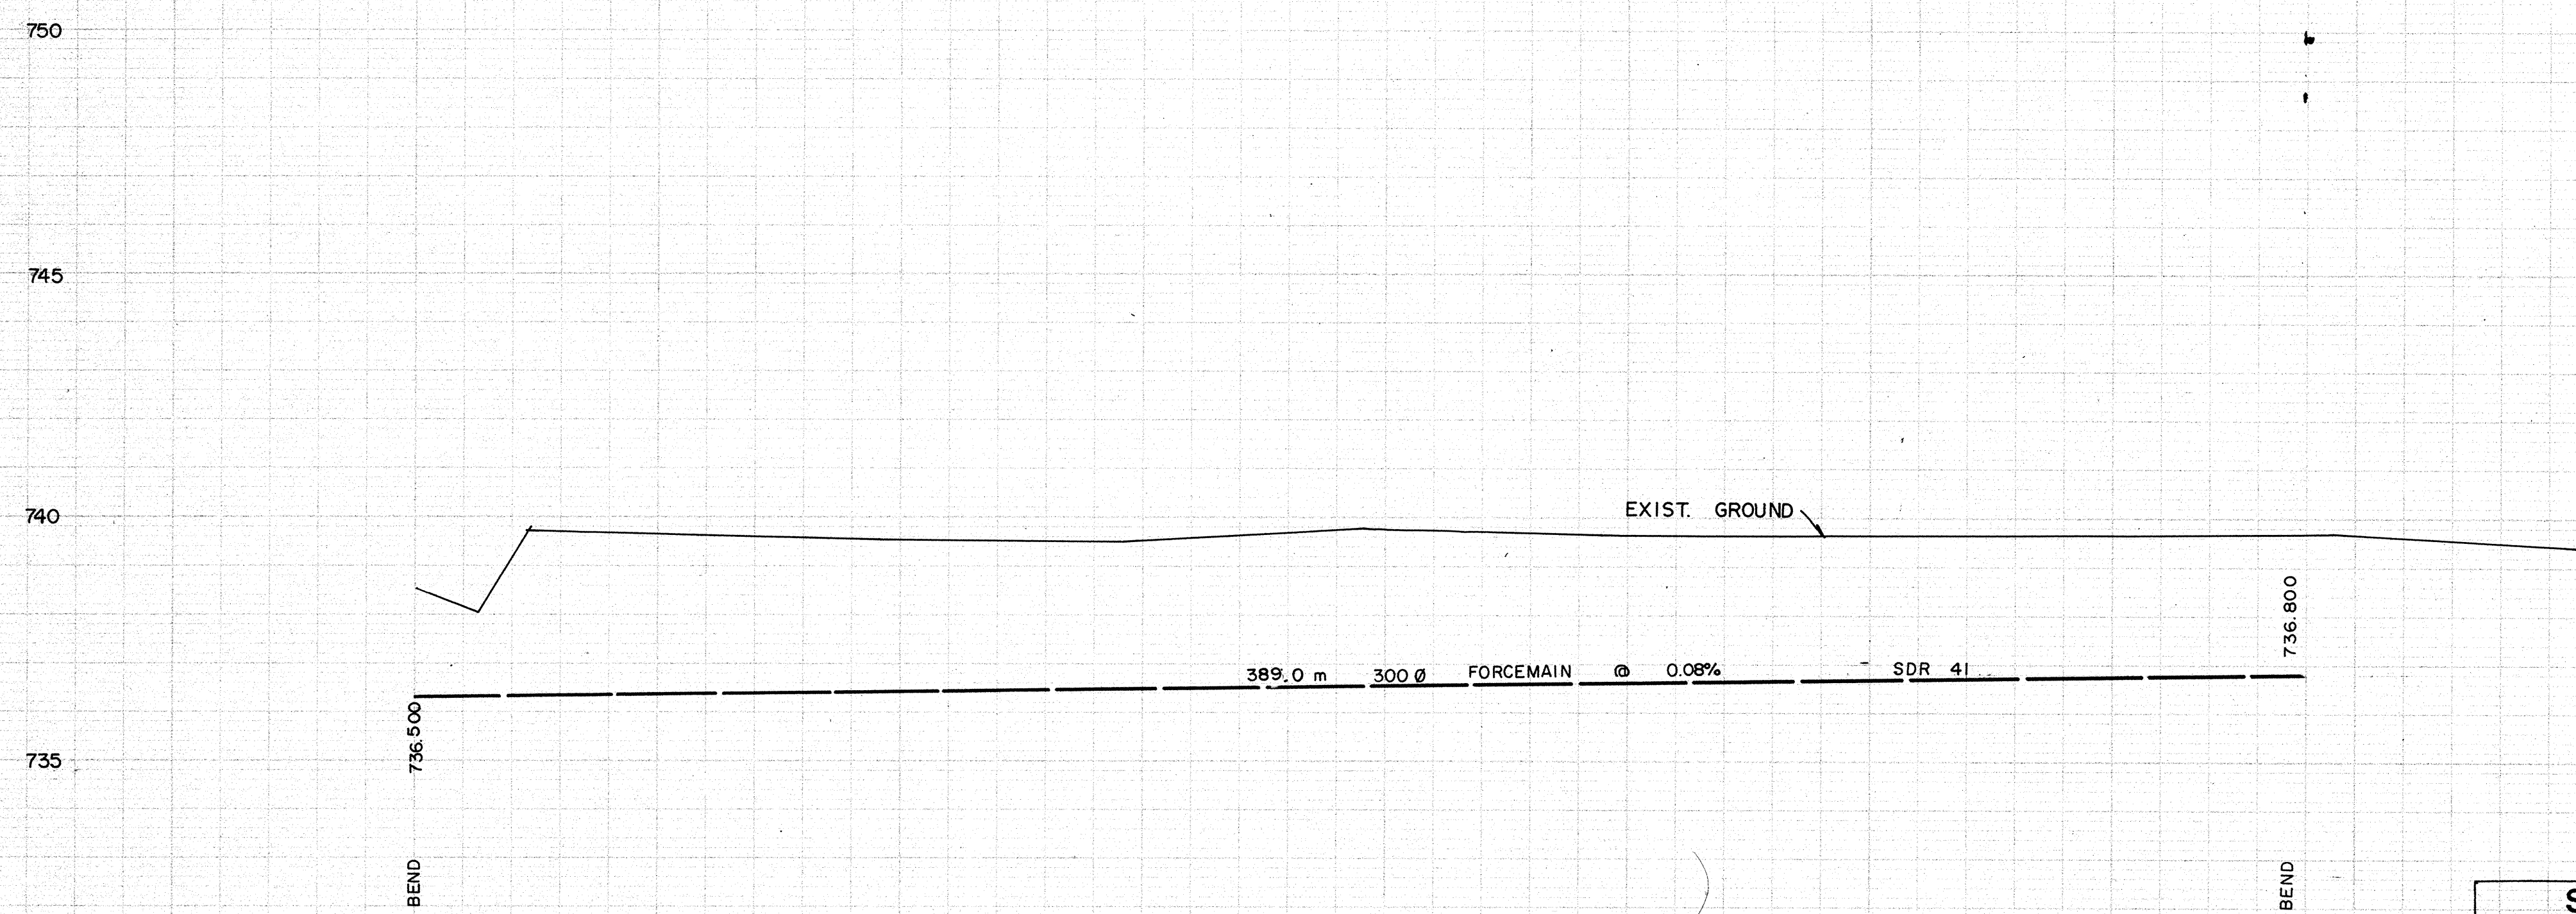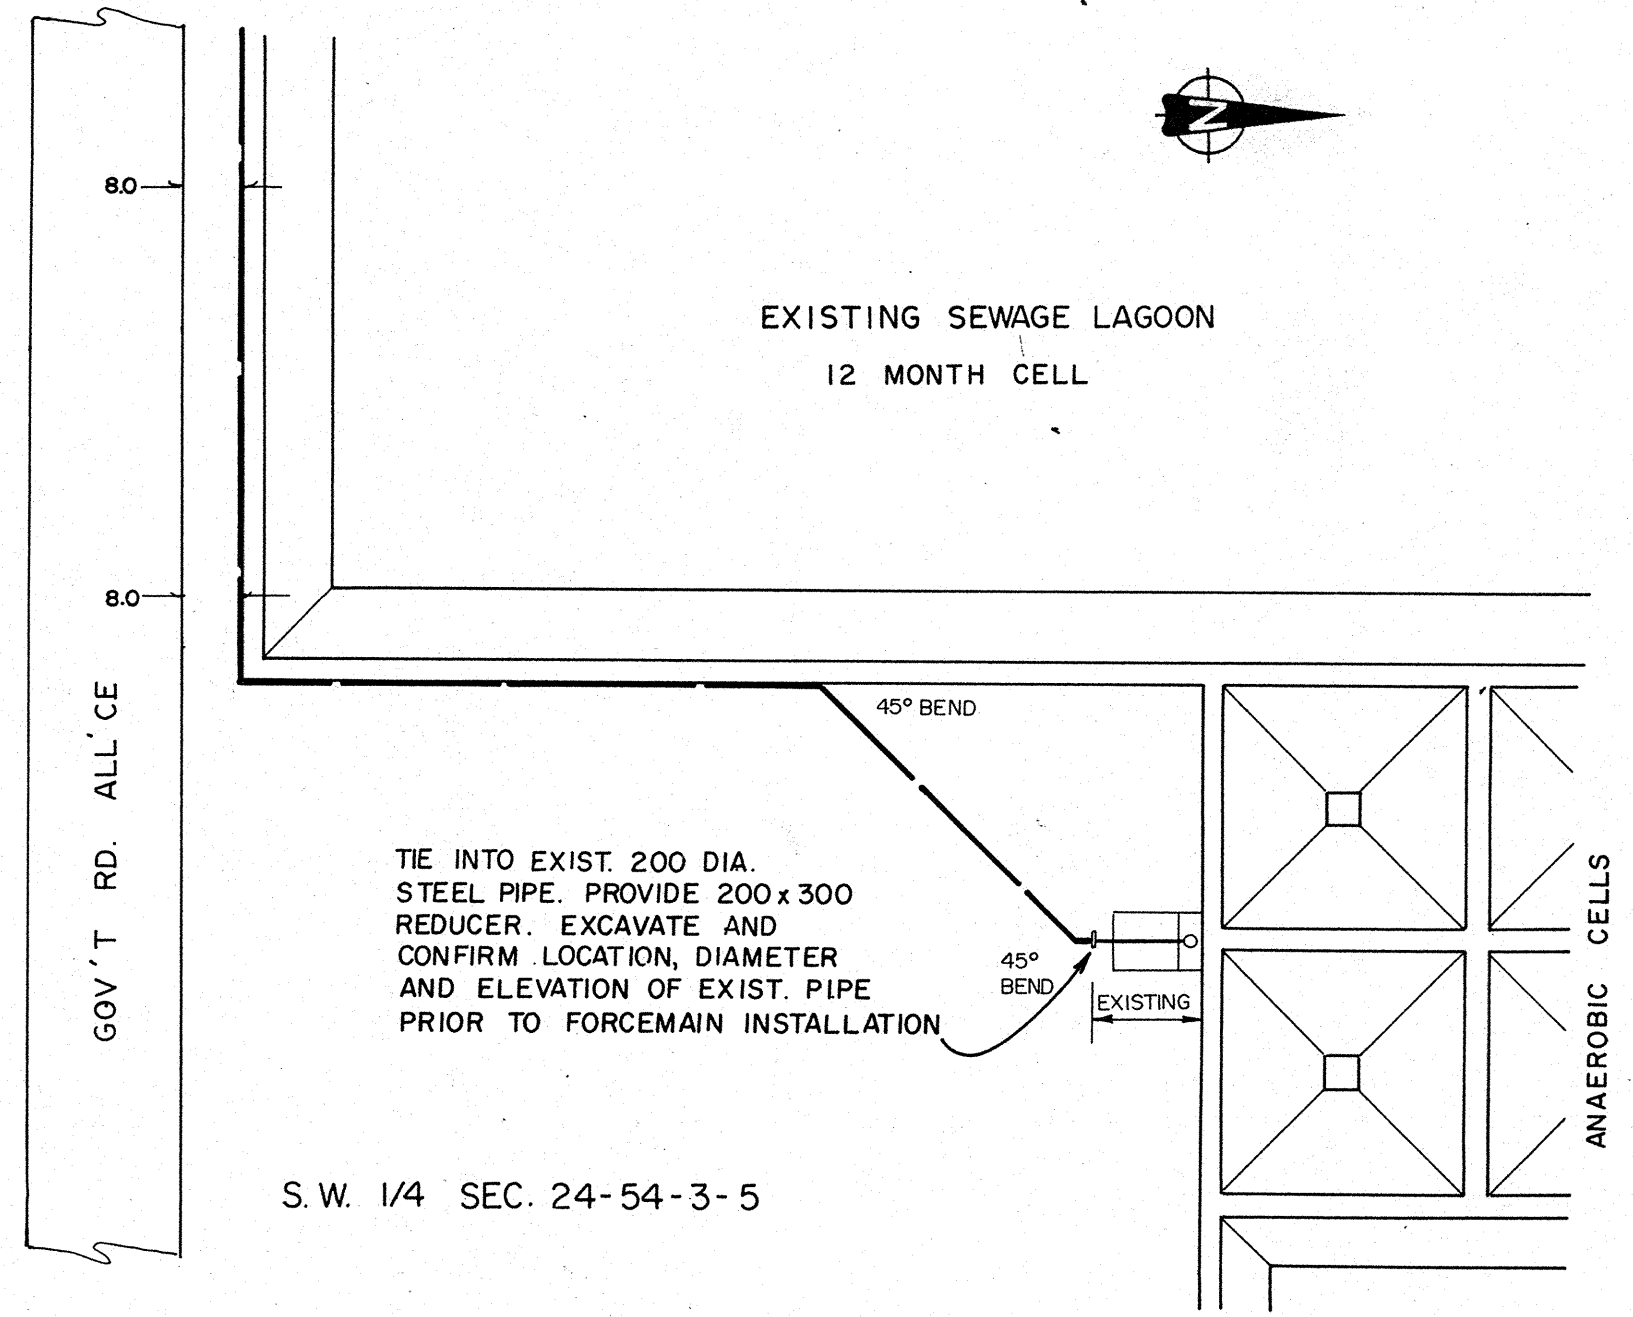


- NOTES:**
1. LOCATION OF EXISTING UTILITIES ARE APPROXIMATE ONLY (A.G.T., GAS, ETC.)
 2. UTILITIES MAY EXIST WHICH ARE NOT SHOWN ON THIS DRAWING.
 3. CONTRACTOR IS RESPONSIBLE FOR GETTING UTILITY COMPANIES TO MARK OUT ALL THEIR LINES (MAINS AND SERVICES).
 4. CONTRACTOR IS RESPONSIBLE FOR ANY DAMAGE TO EXISTING UTILITIES WHETHER SHOWN ON THIS DRAWING OR NOT.

SIEMENS
 SIEMENS ENGINEERING SERVICES LTD.
AS-BUILT
 DATE: 9/01/08
 REVIEWED BY: [Signature]

<p>GRAVITY SEWER, MANHOLE, INVERT, AND DIRECTION OF FLOW</p> <p>FORCEMAIN (300 DIA.)</p> <p>EXISTING GROUND PROFILE AT CONSTRUCTION SITE</p> <p>EXISTING PROPERTY LINE PROFILE AT RIGHT</p> <p>EXISTING PROPERTY LINE PROFILE AT LEFT</p> <p>EXISTING DITCH AT RIGHT OF ROAD</p> <p>EXISTING DITCH AT LEFT OF ROAD</p> <p>FOUND LEGAL MARKER</p> <p>POWER POLE W/ GUY</p> <p>GUY POLE, SERVICE OR LIGHT STANDARD POLE</p> <p>HAND PUMP</p>	<p>LEGEND</p> <p>TEST HOLE OR BORE HOLE</p> <p>AGT PEDESTAL</p> <p>CSP CULVERT W/DIA.</p> <p>CONC. CULVERT W/DIA.</p> <p>FENCE [WF-WIRE, CLF-CHAIN LINK, BF-BEARD, RF-RAIL, GR-GUARDRAIL, SF-SNOW]</p> <p>GAS REGULATOR STATION</p> <p>CATCH BASIN</p> <p>POWER LINE</p> <p>GAS LINE</p> <p>TELEPHONE LINE</p> <p>SERVICE CONNECTION</p>
--	---

PERMIT TO PRACTICE
 SIEMENS ENGINEERING SERVICES LTD.
 Signature: [Signature]
 Date: 09-01-12
PERMIT NUMBER: P 2998
 The Association of Professional Engineers, Geologists and Geophysicists of Alberta

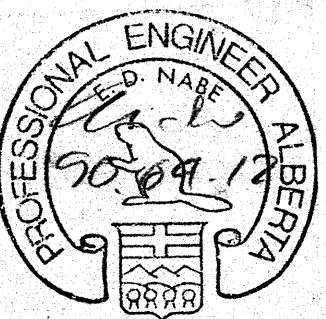

No.	DATE	DESCRIPTION	BY	APP
1	11/90	AS BUILT	DF	PM
REVISIONS				

SCALE
 HORIZ. 20m 10m 0 10m
 VERT. 2.0m 1.0m 0 1.0m

DESIGNED BY EDN
 CHECKED BY [Signature]

PROJECT No. 80-89-1
 DRAWN BY DFF
 DATE MAR., 1990

SIEMENS
 SIEMENS ENGINEERING SERVICES LTD.
 CIVIL & MUNICIPAL ENGINEERS
 DEVELOPMENT CONSULTANTS • PLANNERS

TRI-VILLAGE REGIONAL SEWAGE COMMISSION
 SUMMER VILLAGE OF ALBERTA BEACH
 SEWAGE COLLECTION SYSTEM

FORCEMAIN
 TIE-IN AT EXISTING LAGOON

SHEET OF DWG. No. 2.56