


- NOTES:
1. LOCATION OF EXISTING UTILITIES ARE APPROXIMATE ONLY (A.G.T., GAS, ETC.)
  2. UTILITIES MAY EXIST WHICH ARE NOT SHOWN ON THIS DRAWING.
  3. CONTRACTOR IS RESPONSIBLE FOR GETTING UTILITY COMPANIES TO MARK OUT ALL THEIR LINES (MAINS AND SERVICES).
  4. CONTRACTOR IS RESPONSIBLE FOR ANY DAMAGE TO EXISTING UTILITIES WHETHER SHOWN ON THIS DRAWING OR NOT.

**SIEMENS**  
SIEMENS ENGINEERING SERVICES LTD.  
**AS-BUILT**  
DATE: 9-02-08  
REVIEWED BY: [Signature]

**LEGEND**

GRAVITY SEWER, MANHOLE, INVERT, AND DIRECTION OF FLOW	TEST HOLE OR BORE HOLE
FORCEMAIN (300 DIA.)	AGT PEDESTAL
EXISTING GROUND PROFILE AT CONSTRUCTION SITE	CSP CULVERT WIDIA.
EXISTING PROPERTY LINE PROFILE, AT RIGHT	CONC. CULVERT WIDIA.
EXISTING PROPERTY LINE PROFILE, AT LEFT	FENCE (WF-WIRE, CLF-CHAIN LINK, BF-BOARD, RF-RAIL, GR-GUARDRAIL, SF-SNOW)
EXISTING DITCH AT RIGHT OF ROAD	GAS REGULATOR STATION
EXISTING DITCH AT LEFT OF ROAD	CATCH BASIN
FOUND LEGAL MARKER	POWER LINE
POWER POLE/W/ GLY	GAS LINE
GLY POLE SERVICE OR LIGHT STANDARD POLE	TELEPHONE LINE
HAND PUMP	SERVICE CONNECTION

**PERMIT TO PRACTICE**  
SIEMENS ENGINEERING SERVICES LTD.  
Signature: [Signature]  
Date: 09-04-12  
**PERMIT NUMBER: P 2998**  
The Association of Professional Engineers, Geologists and Geophysicists of Alberta

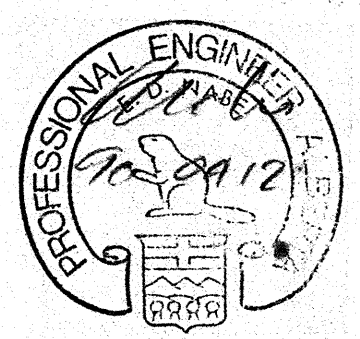

No.	DATE	DESCRIPTION	BY	APP
2	05/92	AS BUILT REVISED	DF	PM
1	11/90	AS BUILT	DF	PM

REVISIONS

SCALE  
HORIZ. 1:100  
VERT. 1:10

DESIGNED BY EDN  
DRAWN BY DFF  
CHECKED BY [Signature]

PROJECT No. 60-89-1  
DATE MAR., 1990

**SIEMENS**  
SIEMENS ENGINEERING SERVICES LTD.  
CIVIL & MUNICIPAL ENGINEERS  
DEVELOPMENT CONSULTANTS • PLANNERS

TRI-VILLAGE REGIONAL SEWAGE COMMISSION  
SUMMER VILLAGE OF ALBERTA BEACH  
SEWAGE COLLECTION SYSTEM  
LANE SOUTH OF 50th AVENUE  
EASTERLY FROM 50th ST.  
SHEET OF DWG. No. 2.57