


NOTES:

1. LOCATION OF EXISTING UTILITIES ARE APPROXIMATE ONLY (A.G.T., GAS, ETC.)
2. UTILITIES MAY EXIST WHICH ARE NOT SHOWN ON THIS DRAWING.
3. CONTRACTOR IS RESPONSIBLE FOR GETTING UTILITY COMPANIES TO MARK OUT ALL THEIR LINES (MAINS AND SERVICES).
4. CONTRACTOR IS RESPONSIBLE FOR ANY DAMAGE TO EXISTING UTILITIES WHETHER SHOWN ON THIS DRAWING OR NOT.

SIEMENS
SIEMENS ENGINEERING SERVICES LTD.
AS-BUILT
DATE: 9/02/08
REVIEWED BY: [Signature]

| LEGEND | |
|--------|---|
| | GRAVITY SEWER, MANHOLE, INVERT, AND DIRECTION OF FLOW |
| | FORCE MAIN (300 DIA.) |
| | EXISTING GROUND PROFILE AT CONSTRUCTION SITE |
| | EXISTING PROPERTY LINE PROFILE, AT RIGHT |
| | EXISTING PROPERTY LINE PROFILE, AT LEFT |
| | EXISTING DITCH AT RIGHT OF ROAD |
| | EXISTING DITCH AT LEFT OF ROAD |
| | FOUND LEGAL MARKER |
| | POWER POLE W/ GUY |
| | GUY POLE, SERVICE OR LIGHT STANDARD POLE |
| | HAND PUMP |
| | TEST HOLE OR BORE HOLE |
| | AGIT PEDESTAL |
| | CSP CULVERT WIDTH |
| | CONC. CULVERT WIDTH |
| | FENCE (W/F WIRE, C/LF-CHAIN LINK, B/F-BOARD, R/F-RAIL, GR-GUARDRAIL, SF-SNOW) |
| | GAS REGULATOR STATION |
| | CATCH BASIN |
| | POWER LINE |
| | GAS LINE |
| | TELEPHONE LINE |
| | SERVICE CONNECTION |

PERMIT TO PRACTICE
SIEMENS ENGINEERING SERVICES LTD.
Signature: [Signature]
Date: 09-02-12
PERMIT NUMBER: P 2998
The Association of Professional Engineers,
Geologists and Geophysicists of Alberta

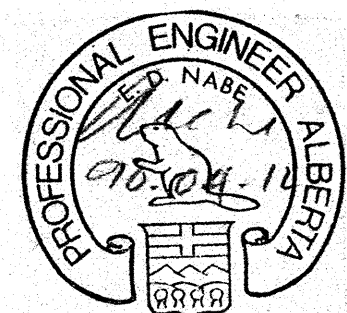

| No. | DATE | DESCRIPTION | BY | APP |
|-----------|-------|-------------|----|-----|
| 1 | 11/30 | AS BUILT | DF | PM |
| REVISIONS | | | | |

| | |
|-------------------------------------|--------------------|
| SCALE HORIZ. 1:100 VERT. 1:10 | |
| DESIGNED BY EDN | DRAWN BY DFF |
| CHECKED BY <u>[Signature]</u> | DATE MAR., 1990 |

PROJECT No. 60-89-1
DRAWN BY DFF
DATE MAR., 1990

SIEMENS
SIEMENS ENGINEERING SERVICES LTD.
CIVIL & MUNICIPAL ENGINEERS
DEVELOPMENT CONSULTANTS • PLANNERS

TRI-VILLAGE REGIONAL SEWAGE COMMISSION
**SUMMER VILLAGE OF ALBERTA BEACH
SEWAGE COLLECTION SYSTEM**
LANE NORTH OF 47th STREET
50th AVE. to 47th AVE.
SHEET _____ OF _____ DWG. No. 2.59