


SIEMENS
SIEMENS ENGINEERING SERVICES LTD.
AS-BUILT
DATE: 91-04-08
REVIEWED BY: [Signature]

- NOTES:**
1. LOCATION OF EXISTING UTILITIES ARE APPROXIMATE ONLY (A.G.T., GAS, ETC.)
 2. UTILITIES MAY EXIST WHICH ARE NOT SHOWN ON THIS DRAWING.
 3. CONTRACTOR IS RESPONSIBLE FOR GETTING UTILITY COMPANIES TO MARK OUT ALL THEIR LINES (MAINS AND SERVICES).
 4. CONTRACTOR IS RESPONSIBLE FOR ANY DAMAGE TO EXISTING UTILITIES WHETHER SHOWN ON THIS DRAWING OR NOT.

| LEGEND | |
|--------|---|
| —○— | GRAVITY SEWER, MANHOLE, INVERT, AND DIRECTION OF FLOW |
| — | FORCEMAIN |
| — | EXISTING GROUND PROFILE AT CONSTRUCTION SITE |
| — | EXISTING PROPERTY LINE PROFILE, AT RIGHT |
| — | EXISTING PROPERTY LINE PROFILE, AT LEFT |
| — | EXISTING DITCH AT RIGHT OF ROAD |
| — | EXISTING DITCH AT LEFT OF ROAD |
| ◆ | FOUND LEGAL MARKER |
| —○— | POWER POLE W/ GUY |
| ○ | GUY POLE, SERVICE OR LIGHT STANDARD POLE |
| ⊕ | HAND PUMP |
| ⊙ | TEST HOLE OR BORE HOLE |
| □ | AGT PEDESTAL |
| — | CSP CULVERT W/DIA. |
| — | CONC. CULVERT W/DIA. |
| — | FENCE (WF-WIRE, CLF-CHAIN LINK, BF-BOARD, RF-RAIL, GR-GUARDRAIL, SF-SNOW) |
| △ | GAS REGULATOR STATION |
| ○ | CATCH BASIN |
| — | POWER LINE |
| — | GAS LINE |
| — | TELEPHONE LINE |
| ◆ | SERVICE CONNECTION |

PERMIT TO PRACTICE
SIEMENS ENGINEERING SERVICES LTD.
Signature: [Signature]
Date: 91-04-17
PERMIT NUMBER: P 2998
The Association of Professional Engineers,
Geologists and Geophysicists of Alberta

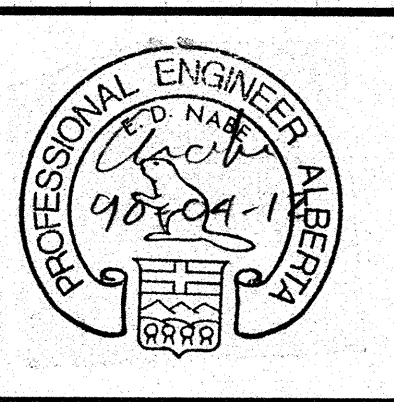

| No. | DATE | DESCRIPTION | BY | APP |
|-----|-------|------------------|----|-----|
| 2 | 05/92 | AS BUILT REVISED | DF | PM |
| 1 | 11/90 | AS BUILT | DF | PM |

SCALE
HORIZ. 1:100
VERT. 1:10
DESIGNED BY EDN
CHECKED BY [Signature]

PROJECT No. 60-89-1
DRAWN BY DFF YJC
DATE MAR., 1990

SIEMENS
SIEMENS ENGINEERING SERVICES LTD.
CIVIL & MUNICIPAL ENGINEERS
DEVELOPMENT CONSULTANTS • PLANNERS

TRI-VILLAGE REGIONAL SEWAGE COMMISSION
SUMMER VILLAGE OF ALBERTA BEACH
SEWAGE COLLECTION SYSTEM
50th AVENUE
54th ST. to 52nd ST.
SHEET OF DWG. No. 2.8