

FORCEMAIN INVERTS TO BE SAME ELEVATION AS GRAVITY SEWER


- NOTES:**
1. LOCATION OF EXISTING UTILITIES ARE APPROXIMATE ONLY (A.G.T., GAS, ETC.)
  2. UTILITIES MAY EXIST WHICH ARE NOT SHOWN ON THIS DRAWING.
  3. CONTRACTOR IS RESPONSIBLE FOR GETTING UTILITY COMPANIES TO MARK OUT ALL THEIR LINES (MAINS AND SERVICES).
  4. CONTRACTOR IS RESPONSIBLE FOR ANY DAMAGE TO EXISTING UTILITIES WHETHER SHOWN ON THIS DRAWING OR NOT.

**SIEMENS**  
SIEMENS ENGINEERING SERVICES LTD.  
**AS-BUILT**  
DATE: 91-04-03  
REVIEWED BY: [Signature]

**LEGEND**

○ MH	GRAVITY SEWER, MANHOLE, INVERT, AND DIRECTION OF FLOW	○	TEST HOLE OR BORE HOLE
—	FORCEMAIN (100 DIA.)	□	AGT PEDESTAL
---	EXISTING GROUND PROFILE AT CONSTRUCTION SITE	—	CSP CULVERT WIDTH
---	EXISTING PROPERTY LINE PROFILE, AT RIGHT	—	CONC. CULVERT WIDTH
---	EXISTING PROPERTY LINE PROFILE, AT LEFT	—	FENCE W/F WIRE, C/F-CHAIN LINK, BF-BOARD, RF-RAIL, GR-GUARDRAIL, SF-SNOW
---	EXISTING DITCH AT RIGHT OF ROAD	△	GAS REGULATOR STATION
---	EXISTING DITCH AT LEFT OF ROAD	○	CATCH BASIN
◆	FOUND LEGAL MARKER	—	POWER LINE
○	POWER POLE W/ GUY	—	GAS LINE
○	GUY POLE, SERVICE OR LIGHT STANDARD POLE	—	TELEPHONE LINE
⊕	HAND PUMP	▼	SERVICE CONNECTION

**PERMIT TO PRACTICE**  
SIEMENS ENGINEERING SERVICES LTD.  
Signature: [Signature]  
Date: 90-CA-12  
**PERMIT NUMBER: P 2998**  
The Association of Professional Engineers, Geologists and Geophysicists of Alberta

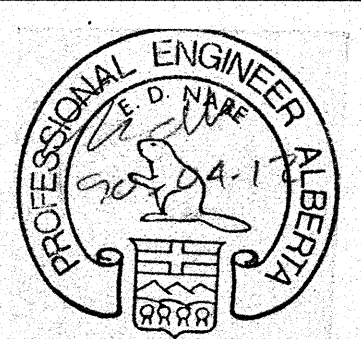

No.	DATE	DESCRIPTION	BY	APP
2	07/94	SERVICE CONNECTION LOT 10, BLK. 2, 1588CL	DF	PKS
1	11/90	AS BUILT	DF	PM

**REVISIONS**

SCALE  
HORIZ. 1:1000  
VERT. 1:50

DESIGNED BY EDN  
CHECKED BY [Signature]

PROJECT No. 60-89-1  
DRAWN BY DFF  
DATE MAR., 1990

**SIEMENS**  
SIEMENS ENGINEERING SERVICES LTD.  
CIVIL & MUNICIPAL ENGINEERS  
DEVELOPMENT CONSULTANTS • PLANNERS

TRI-VILLAGE REGIONAL SEWAGE COMMISSION  
**SUMMER VILLAGE OF SUNSET POINT SEWAGE COLLECTION SYSTEM**  
SUNSET DRIVE  
44th AVE. to 46th AVE.  
SHEET \_\_\_\_\_ OF \_\_\_\_\_ DWG. No. 3.1

DEPT. OF PUBLIC WORKS  
PLAN 3  
1588 CL