


- NOTES:**
1. LOCATION OF EXISTING UTILITIES ARE APPROXIMATE ONLY (A.G.T., GAS, ETC.)
  2. UTILITIES MAY EXIST WHICH ARE NOT SHOWN ON THIS DRAWING.
  3. CONTRACTOR IS RESPONSIBLE FOR GETTING UTILITY COMPANIES TO MARK OUT ALL THEIR LINES (MAINS AND SERVICES).
  4. CONTRACTOR IS RESPONSIBLE FOR ANY DAMAGE TO EXISTING UTILITIES WHETHER SHOWN ON THIS DRAWING OR NOT.

**SIEMENS**  
SIEMENS ENGINEERING SERVICES LTD.  
**AS-BUILT**  
DATE: 91-04-03  
REVIEWED BY: [Signature]

**LEGEND**

—○—	GRAVITY SEWER, MANHOLE, INVERT, AND DIRECTION OF FLOW	⊙	TEST HOLE OR BORE HOLE
—	FORCE MAIN	□	AGT PEDESTAL
—	EXISTING GROUND PROFILE AT CONSTRUCTION SITE	—	CSP CULVERT WIDIA.
—	EXISTING PROPERTY LINE PROFILE, AT RIGHT	—	CONC. CULVERT WIDIA.
—	EXISTING PROPERTY LINE PROFILE, AT LEFT	—	FENCE (WF-WIRE, CLF-CHAIN LINK, BF-BOARD, RF-RAIL, GR-GUARDRAIL, SF-SNOW)
—	EXISTING DITCH AT RIGHT OF ROAD	△	GAS REGULATOR STATION
—	EXISTING DITCH AT LEFT OF ROAD	○	CATCH BASIN
◆	FOUND LEGAL MARKER	—	POWER LINE
—	POWER POLE W/ GLY	—	GAS LINE
○	GLY POLE, SERVICE OR LIGHT STANDARD POLE	—	TELEPHONE LINE
⊕	HAND PUMP	▼	SERVICE CONNECTION

**PERMIT TO PRACTICE**  
SIEMENS ENGINEERING SERVICES LTD.  
Signature: [Signature]  
Date: 91-04-12  
**PERMIT NUMBER: P 2398**  
The Association of Professional Engineers, Geologists and Geophysicists of Alberta

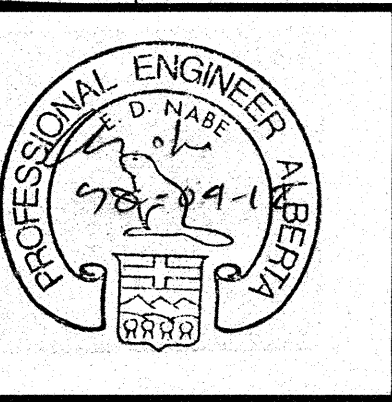

No.	DATE	DESCRIPTION	BY	APP
1	11/90	AS BUILT	DF	PM
REVISIONS				

SCALE HORIZ. 1:500 VERT. 1:100	DESIGNED BY EDN	PROJECT No. 60-89-1
CHECKED BY [Signature]	DRAWN BY DFF	DATE MAR., 1990

**SIEMENS**  
SIEMENS ENGINEERING SERVICES LTD.  
CIVIL & MUNICIPAL ENGINEERS  
DEVELOPMENT CONSULTANTS • PLANNERS

**TRI-VILLAGE REGIONAL SEWAGE COMMISSION**  
**SUMMER VILLAGE OF SUNSET POINT**  
**SEWAGE COLLECTION SYSTEM**  
49A AVENUE  
SUNSET DRIVE to 48th ST.  
SHEET OF DWG. No. 3.12