


- NOTES:**
1. LOCATION OF EXISTING UTILITIES ARE APPROXIMATE ONLY (A.G.T., GAS, ETC.)
  2. UTILITIES MAY EXIST WHICH ARE NOT SHOWN ON THIS DRAWING.
  3. CONTRACTOR IS RESPONSIBLE FOR GETTING UTILITY COMPANIES TO MARK OUT ALL THEIR LINES (MAINS AND SERVICES).
  4. CONTRACTOR IS RESPONSIBLE FOR ANY DAMAGE TO EXISTING UTILITIES WHETHER SHOWN ON THIS DRAWING OR NOT.

**SIEMENS**  
SIEMENS ENGINEERING SERVICES LTD.  
**AS-BUILT**  
DATE: 9-04-03  
REVIEWED BY: *[Signature]*

**PERMIT TO PRACTICE**  
SIEMENS ENGINEERING SERVICES LTD.  
Signature: *[Signature]*  
Date: 90-02-12  
PERMIT NUMBER: P 2998  
The Association of Professional Engineers,  
Geologists and Geophysicists of Alberta

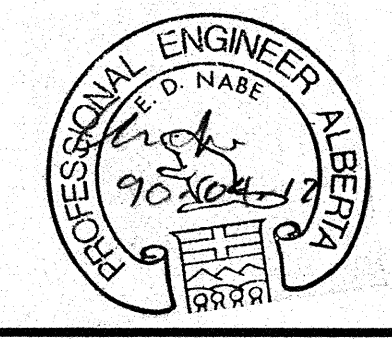

No.	DATE	DESCRIPTION	DF	PM
1	11/90	AS BUILT		
REVISIONS				

SCALE: 10m 5 0 5  
HORIZ. 1:100  
VERT. 1:10  
DESIGNED BY: EDN  
CHECKED BY: *[Signature]*

PROJECT No. 60-89-1  
DRAWN BY: DFF  
DATE: MAR., 1990

- LEGEND**
- 722 MH: GRAVITY SEWER, MANHOLE, INVERT, AND DIRECTION OF FLOW
  - : FORCE MAIN
  - - - - -: EXISTING GROUND PROFILE AT CONSTRUCTION SITE
  - - - - -: EXISTING PROPERTY LINE PROFILE AT RIGHT
  - - - - -: EXISTING PROPERTY LINE PROFILE AT LEFT
  - - - - -: EXISTING DITCH AT RIGHT OF ROAD
  - - - - -: EXISTING DITCH AT LEFT OF ROAD
  - ◆: FOUND LEGAL MARKER
  - : POWER POLE W/ GUY
  - : GUY POLE, SERVICE OR LIGHT STANDARD POLE
  - ⊕: HAND PUMP
  - ⊙: TEST HOLE OR BOREHOLE
  - : AGT PEDESTAL
  - : CSP CULVERT W/DIA.
  - : CONC. CULVERT W/DIA.
  - : FENCE (WF-WIRE, CLF-CHAIN LINK, BF-BEARD, RF-RAIL, SF-GUARDRAIL, SF-SNOW)
  - ⊙: GAS REGULATOR STATION
  - ⊙: CATCH BASIN
  - : POWER LINE
  - : GAS LINE
  - : TELEPHONE LINE
  - ▽: SERVICE CONNECTION

**SIEMENS**  
SIEMENS ENGINEERING SERVICES LTD.  
CIVIL & MUNICIPAL ENGINEERS  
DEVELOPMENT CONSULTANTS • PLANNERS

**TRI-VILLAGE REGIONAL SEWAGE COMMISSION**  
**SUMMER VILLAGE OF SUNSET POINT**  
**SEWAGE COLLECTION SYSTEM**  
49A AVENUE  
SUNSET DRIVE TO 48th ST.  
SHEET \_\_\_\_\_ OF \_\_\_\_\_ DWG. No. 3.13