


**SIEMENS**  
SIEMENS ENGINEERING SERVICES LTD.  
**AS-BUILT**  
DATE: 91-04-03  
REVIEWED BY: [Signature]

- NOTES:**
1. LOCATION OF EXISTING UTILITIES ARE APPROXIMATE ONLY (A.G.T., GAS, ETC.)
  2. UTILITIES MAY EXIST WHICH ARE NOT SHOWN ON THIS DRAWING.
  3. CONTRACTOR IS RESPONSIBLE FOR GETTING UTILITY COMPANIES TO MARK OUT ALL THEIR LINES (MAINS AND SERVICES).
  4. CONTRACTOR IS RESPONSIBLE FOR ANY DAMAGE TO EXISTING UTILITIES WHETHER SHOWN ON THIS DRAWING OR NOT.

**LEGEND**

○	GRAVITY SEWER, MANHOLE, INVERT, AND DIRECTION OF FLOW	○	TEST HOLE OR BORE HOLE
○	FORCE MAIN (100 DIA.)	□	AST PEDESTAL
---	EXISTING GROUND PROFILE AT CONSTRUCTION SITE	---	CSP CULVERT W/DIA.
---	EXISTING PROPERTY LINE PROFILE, AT RIGHT	---	CONC. CULVERT W/DIA.
---	EXISTING PROPERTY LINE PROFILE, AT LEFT	---	FENCE (W/F WIRE, C/LF CHAIN LINK, BF-BOARD, RF-RAIL, GR-GUARDRAIL, SF-SNOW)
---	EXISTING DITCH AT RIGHT OF ROAD	△	GAS REGULATOR STATION
---	EXISTING DITCH AT LEFT OF ROAD	△	CATCH BASIN
◆	FOUND LEGAL MARKER	—	POWER LINE
○	POWER POLE W/ GUY	—	GASLINE
○	GUY POLE, SERVICE OR LIGHT STANDARD POLE	—	TELEPHONE LINE
+	HAND PUMP	▼	SERVICE CONNECTION

**PERMIT TO PRACTICE**  
SIEMENS ENGINEERING SERVICES LTD.  
Signature: [Signature]  
Date: 91-04-12  
**PERMIT NUMBER: P 2998**  
The Association of Professional Engineers,  
Geologists and Geophysicists of Alberta

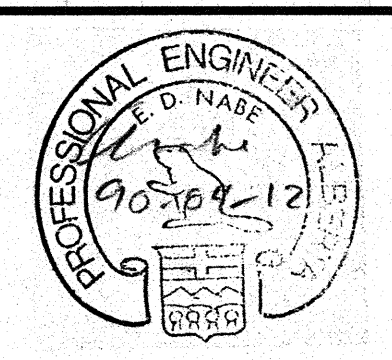

No.	DATE	DESCRIPTION	BY	APP
1	11/90	AS BUILT	DF	PM
REVISIONS				

SCALE HORIZ. 1:100 VERT. 1:10	PROJECT No. 60-89-1
DESIGNED BY EDN	DRAWN BY DFF
CHECKED BY [Signature]	DATE MAR., 1990

**SIEMENS**  
SIEMENS ENGINEERING SERVICES LTD.  
CIVIL & MUNICIPAL ENGINEERS  
DEVELOPMENT CONSULTANTS • PLANNERS

TRI-VILLAGE REGIONAL SEWAGE COMMISSION	
SUMMER VILLAGE OF SUNSET POINT SEWAGE COLLECTION SYSTEM	
55TH AVENUE	
SHEET	DWG. No. 3.16