


- NOTES:
1. LOCATION OF EXISTING UTILITIES ARE APPROXIMATE ONLY (A.G.T., GAS, ETC.)
 2. UTILITIES MAY EXIST WHICH ARE NOT SHOWN ON THIS DRAWING.
 3. CONTRACTOR IS RESPONSIBLE FOR GETTING UTILITY COMPANIES TO MARK OUT ALL THEIR LINES (MAINS AND SERVICES).
 4. CONTRACTOR IS RESPONSIBLE FOR ANY DAMAGE TO EXISTING UTILITIES WHETHER SHOWN ON THIS DRAWING OR NOT.

LEGEND	
—○— MH	GRAVITY SEWER, MANHOLE, INVERT, AND DIRECTION OF FLOW
—	FORCE MAIN
—	EXISTING GROUND PROFILE AT CONSTRUCTION SITE
—	EXISTING PROPERTY LINE PROFILE, AT RIGHT
—	EXISTING PROPERTY LINE PROFILE, AT LEFT
—	EXISTING DITCH AT RIGHT OF ROAD
—	EXISTING DITCH AT LEFT OF ROAD
—	FOUND LEGAL MARKER
—	POWER POLE W/ GUY
—	GUY POLE, SERVICE OR LIGHT STANDARD POLE
—	HAND PUMP
—	TEST HOLE OR BORE HOLE
—	AGT PEDESTAL
—	CSP CULVERT W/DIA.
—	CONC. CULVERT W/DIA.
—	FENCE (W/ WIRE, CLF-CHAIN LINK, BF-BOARD, RF-RAIL, OR-GUARDRAIL, SF-SNOW)
—	GAS REGULATOR STATION
—	CATCH BASIN
—	POWER LINE
—	GAS LINE
—	TELEPHONE LINE
—	SERVICE CONNECTION

SIEMENS
SIEMENS ENGINEERING SERVICES LTD.
AS-BUILT
DATE: 91-04-03
REVIEWED BY: [Signature]

PERMIT TO PRACTICE
SIEMENS ENGINEERING SERVICES LTD.
Signature: [Signature]
Date: 91-04-12
PERMIT NUMBER: P 2398
The Association of Professional Engineers,
Geologists and Geophysicists of Alberta

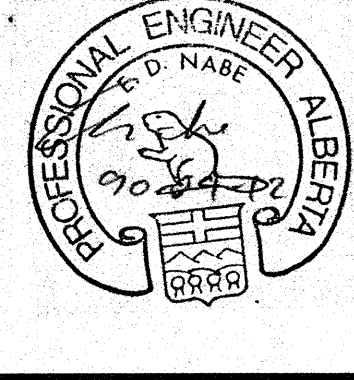

REVISIONS	
No.	DATE
1	11/90
AS BUILT	DF PM
BY	APP

SCALE HORIZ. VERT.	10m 5 0 5 1.0m 0.5 0 0.5
DESIGNED BY EDN	
CHECKED BY	

PROJECT No. 60-89-1	DRAWN BY DFF
DATE MAR., 1990	

SIEMENS
SIEMENS ENGINEERING SERVICES LTD.
CIVIL & MUNICIPAL ENGINEERS
DEVELOPMENT CONSULTANTS • PLANNERS

TRI-VILLAGE REGIONAL SEWAGE COMMISSION	
SUMMER VILLAGE OF SUNSET POINT SEWAGE COLLECTION SYSTEM	
49TH STREET CUL-DE-SAC TO 56 AVE. & LANE OFF 56 AVE.	
SHEET	OF
DWG. No.	3.18