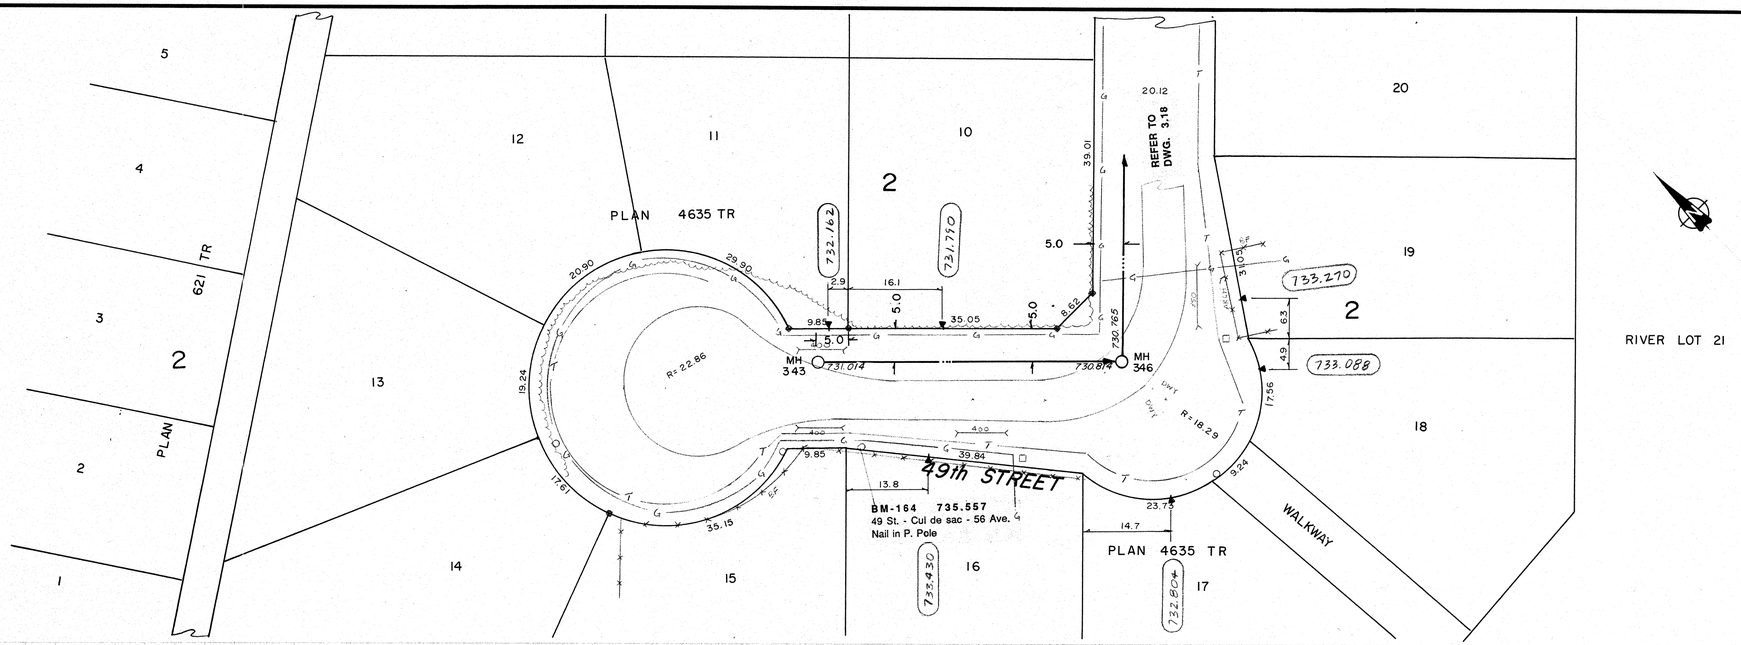

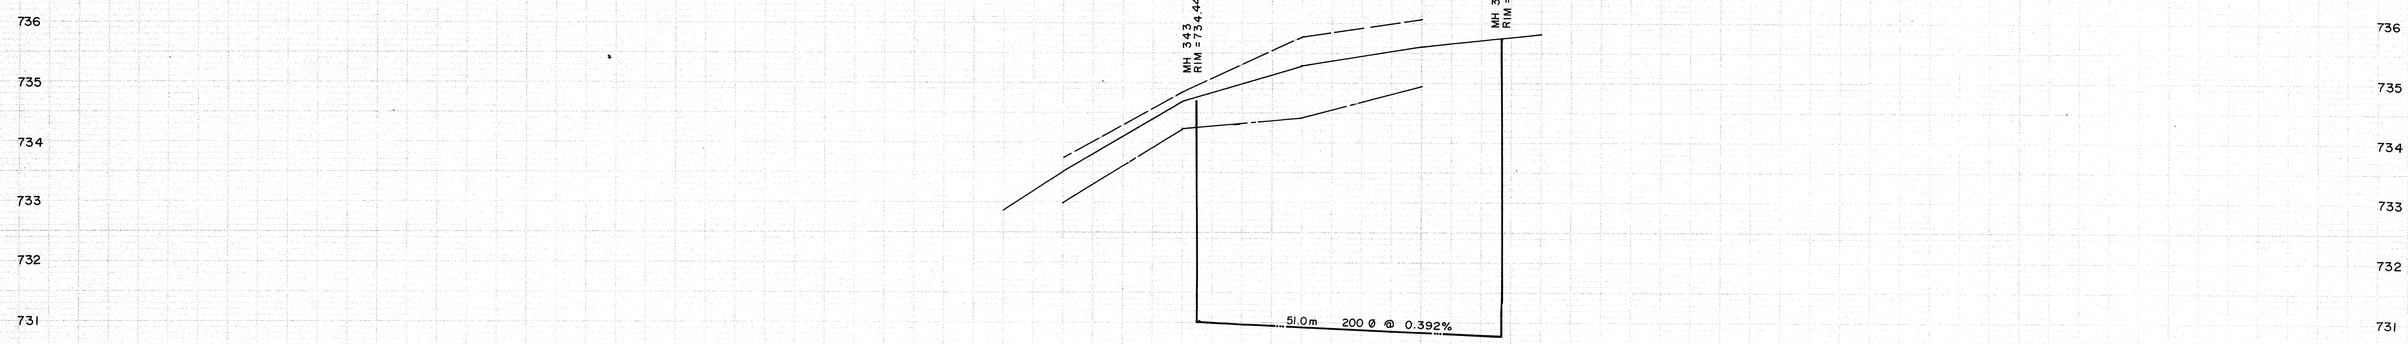

SIEMENS
SIEMENS ENGINEERING SERVICES LTD.
AS-BUILT
DATE: 91-04-03
REVIEWED BY:

NOTES:

1. LOCATION OF EXISTING UTILITIES ARE APPROXIMATE ONLY (A.G.T., GAS, ETC.)
2. UTILITIES MAY EXIST WHICH ARE NOT SHOWN ON THIS DRAWING.
3. CONTRACTOR IS RESPONSIBLE FOR GETTING UTILITY COMPANIES TO MARK OUT ALL THEIR LINES (MAINS AND SERVICES).
4. CONTRACTOR IS RESPONSIBLE FOR ANY DAMAGE TO EXISTING UTILITIES WHETHER SHOWN ON THIS DRAWING OR NOT.

LEGEND

- GRAVITY SEWER, MANHOLE, INVERT, AND DIRECTION OF FLOW
- FORCEMAIN
- EXISTING GROUND PROFILE AT CONSTRUCTION SITE
- EXISTING PROPERTY LINE PROFILE, AT RIGHT
- EXISTING PROPERTY LINE PROFILE, AT LEFT
- EXISTING DITCH AT RIGHT OF ROAD
- EXISTING DITCH AT LEFT OF ROAD
- FOUND LEGAL MARKER
- POWER POLE W/ GUY
- GUY POLE, SERVICE OR LIGHT STANDARD POLE
- HAND PUMP
- TEST HOLE OR BORE HOLE
- AGT PEDESTAL
- CSP CULVERT W/DIA.
- CONC. CULVERT W/DIA.
- FENCE [WF-WIRE, CLF-CHAIN LINK, BF-BOARD, RF-RAIL, GR-GUARDRAIL, SF-SNOW]
- GAS REGULATOR STATION
- CATCH BASIN
- POWER LINE
- SERVICE CONNECTION
- GAS LINE
- TELEPHONE LINE

PERMIT TO PRACTICE
SIEMENS ENGINEERING SERVICES LTD.
Signature
Date 90-04-12
PERMIT NUMBER: P 2998
The Association of Professional Engineers, Geologists and Geophysicists of Alberta

PROFESSIONAL ENGINEER ALBERTA

No.	DATE	DESCRIPTION	BY	APP
1	11/90	AS BUILT	DF	PM

REVISIONS

SCALE HORIZ. 10m 5 0 5
VERT. 1.0m 0.5 0 0.5

PROJECT No. 60-89-1
DESIGNED BY EDN
DRAWN BY DFF
CHECKED BY
DATE MAR., 1990

SIEMENS
SIEMENS ENGINEERING SERVICES LTD.
CIVIL & MUNICIPAL ENGINEERS
DEVELOPMENT CONSULTANTS • PLANNERS

TRI-VILLAGE REGIONAL SEWAGE COMMISSION
SUMMER VILLAGE OF SUNSET POINT SEWAGE COLLECTION SYSTEM

SHEET ..... OF ..... DWG. No. 3.17